


T. 34 S.R. 1 W.W.M.

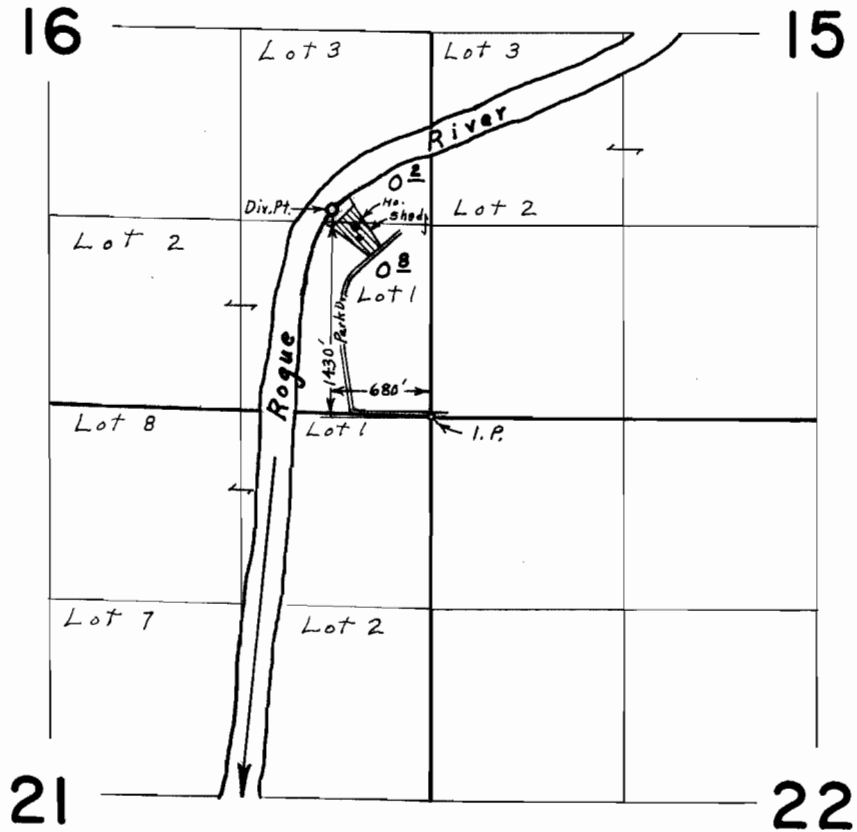

FINAL PROOF SURVEY
UNDER

Application No. 37467 Permit No. 27942
IN NAME OF

FREDERICK T. & ARLENE E. WALSH

Surveyed May 20, 1968, by L. E. Gould