


T. 33 S. R. 1 E. W. M.

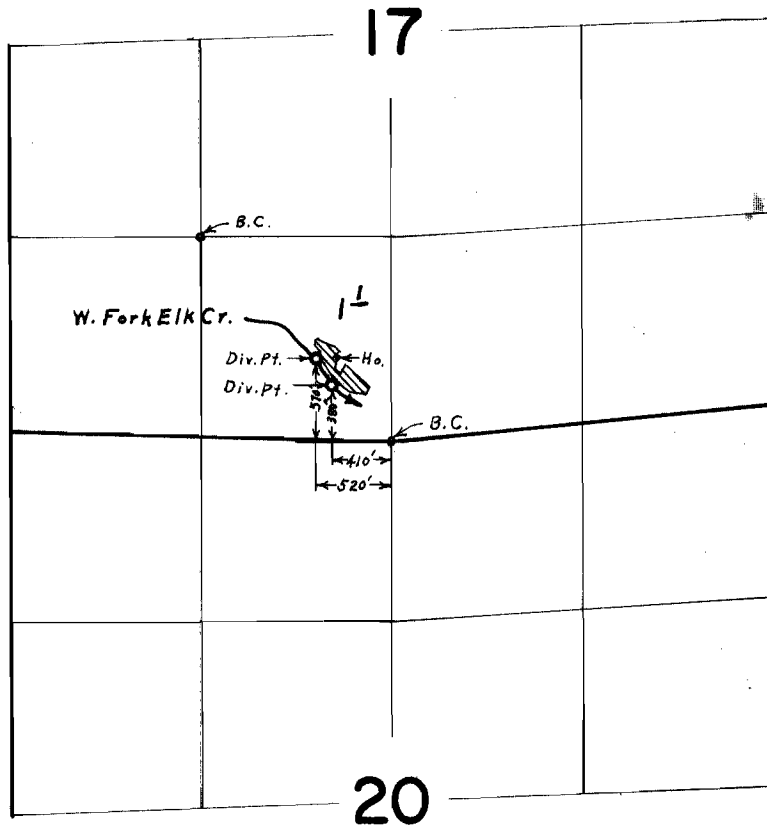

FINAL PROOF SURVEY
UNDER

Application No. 38476 Permit No. 28651
IN NAME OF

FRANK R. & AGNES M. NELSON

Surveyed May 17, 1968, by L. E. Gould