


T. 33 S. R. 1 E. W. M.

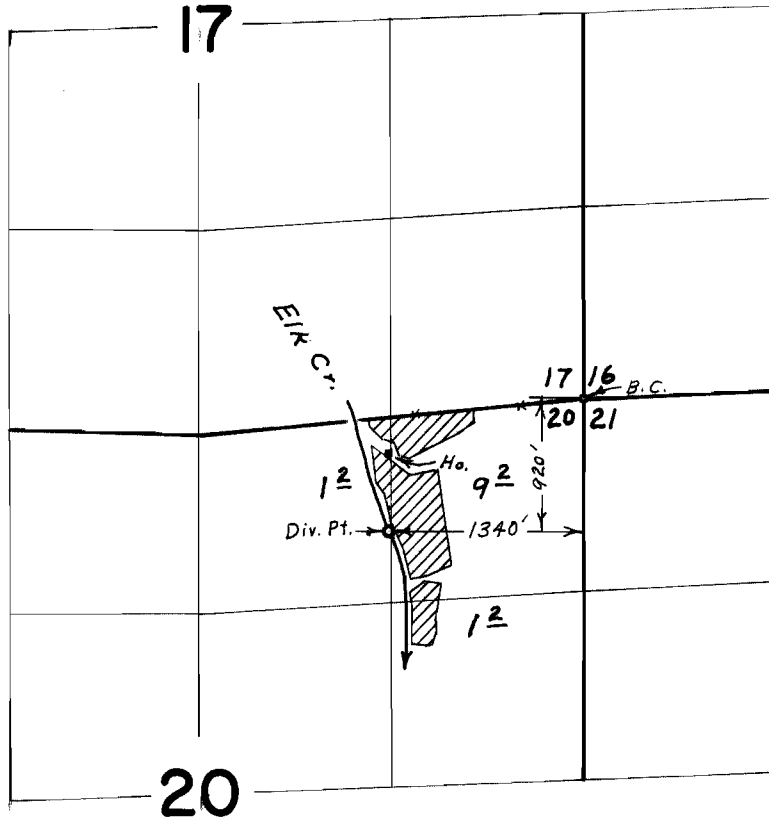

FINAL PROOF SURVEY UNDER

Application No. 38501 Permit No. 28662

IN NAME OF

IRVIN D. & GERTRUDE L. ROSS

Surveyed May 18, 1968, by L. E. Gould