


T. 36S.R. 4 W. W.M.

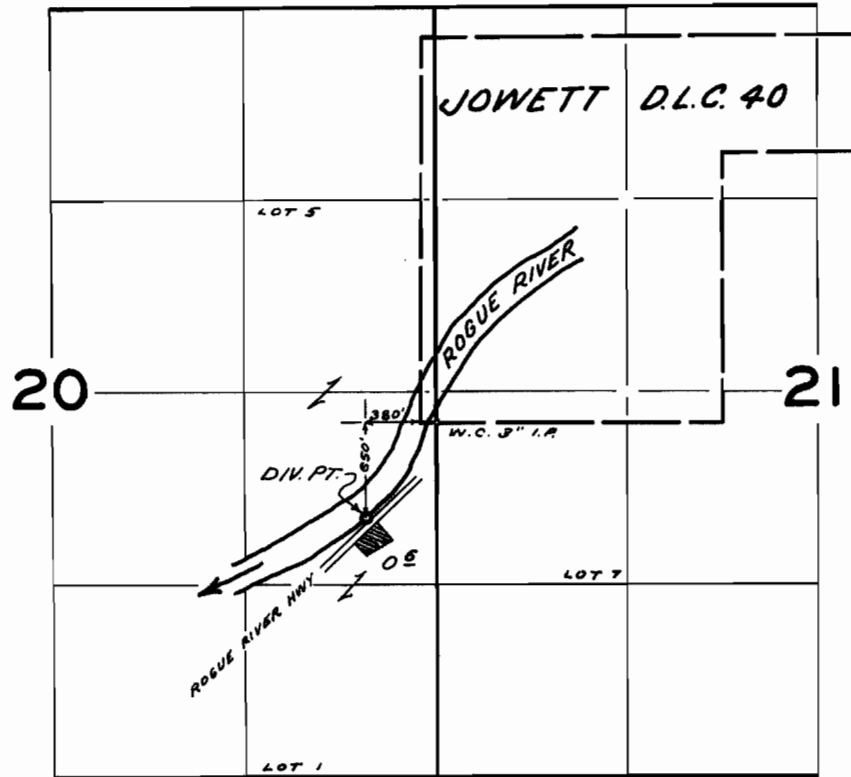

FINAL PROOF SURVEY
UNDER

Application No. 38665 Permit No. 28773
IN NAME OF

MRS. VIOLET G. MOREY

Surveyed JUN 4 1968, by V. GARNER