T. 34 S. R. 1 W. W.M.

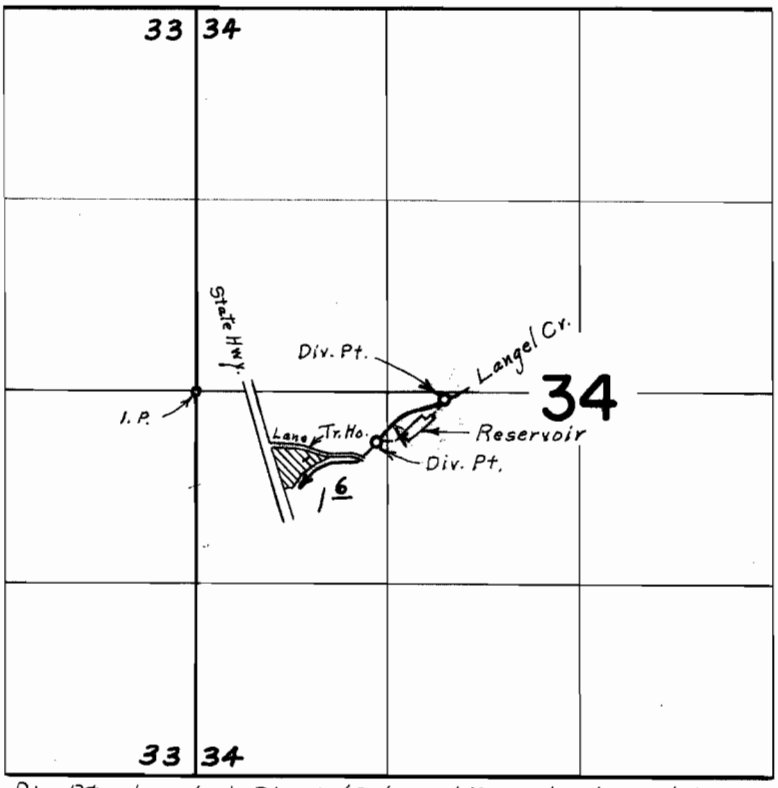

Div. Pts. Located; Str., 40' S. & 1700' E., 340' S. & 1230' E., Res. 300' S. & 1400' E., All from West ¼ Cor. Section 34.

FINAL PROOF SURVEY
UNDER

Application No. R-39161 38839 Permit No. R-3697 29021

IN NAME OF

PAUL M. ROBINSON

Surveyed May 23, 1968, by L. E. Gould

1968-T