


T. 33 S. R. 1 E. W. M.

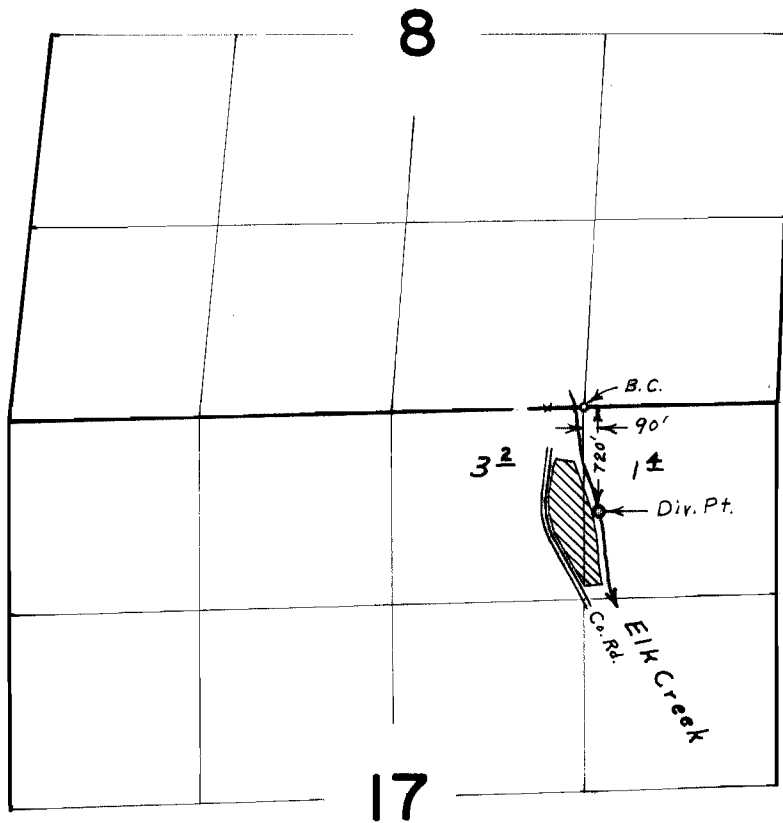

FINAL PROOF SURVEY
UNDER

Application No. 39812 Permit No. 29587
IN NAME OF

MRS. JUNE E. MYERS

Surveyed May 17, 1968, by L. E. Gould