


T. 36 S. R. 4 W. W.M.

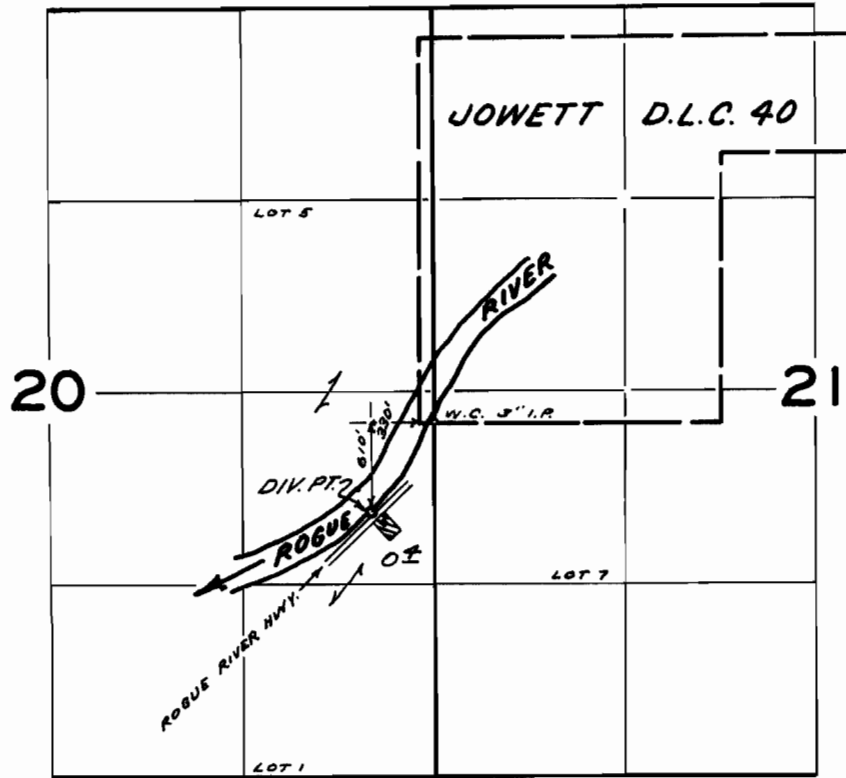

FINAL PROOF SURVEY
UNDER

Application No. 39858 Permit No. 29671
IN NAME OF

ROBERT R. RAUSCH

Surveyed JUN. 4 1968, by V. GARNER