


T. 36S.R. 3 W.W.M.

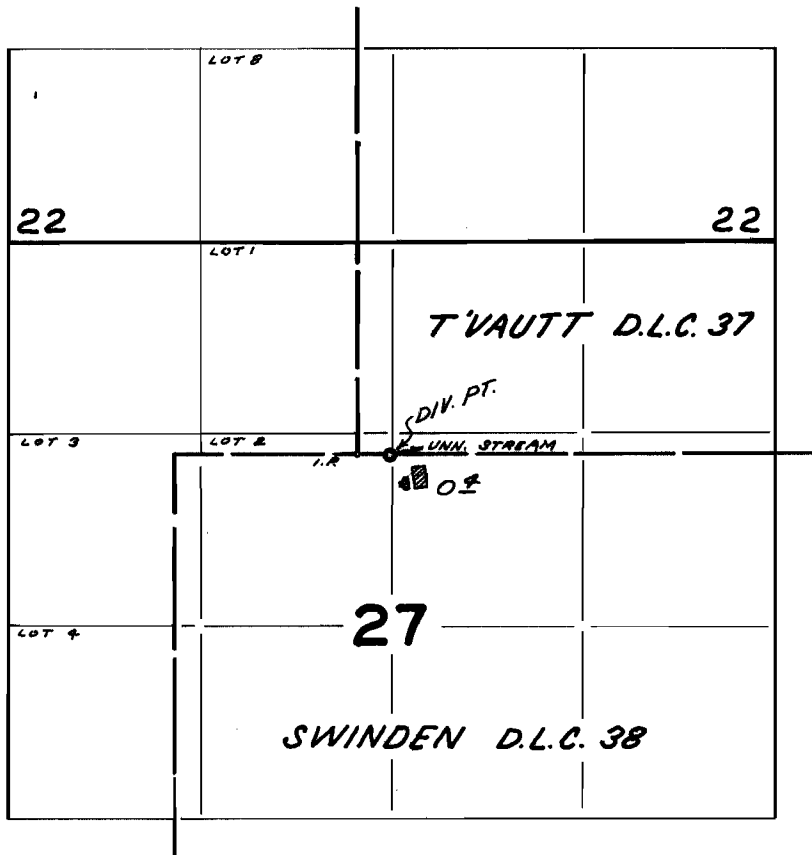

FINAL PROOF SURVEY  
UNDER

Application No. 40019 Permit No. 29805  
IN NAME OF

DAVID J. AND PAULETTE FRANK

Surveyed JUN. 12, 1968, by V. GARNER