


T. 33 S. R. 3 E. W. M.

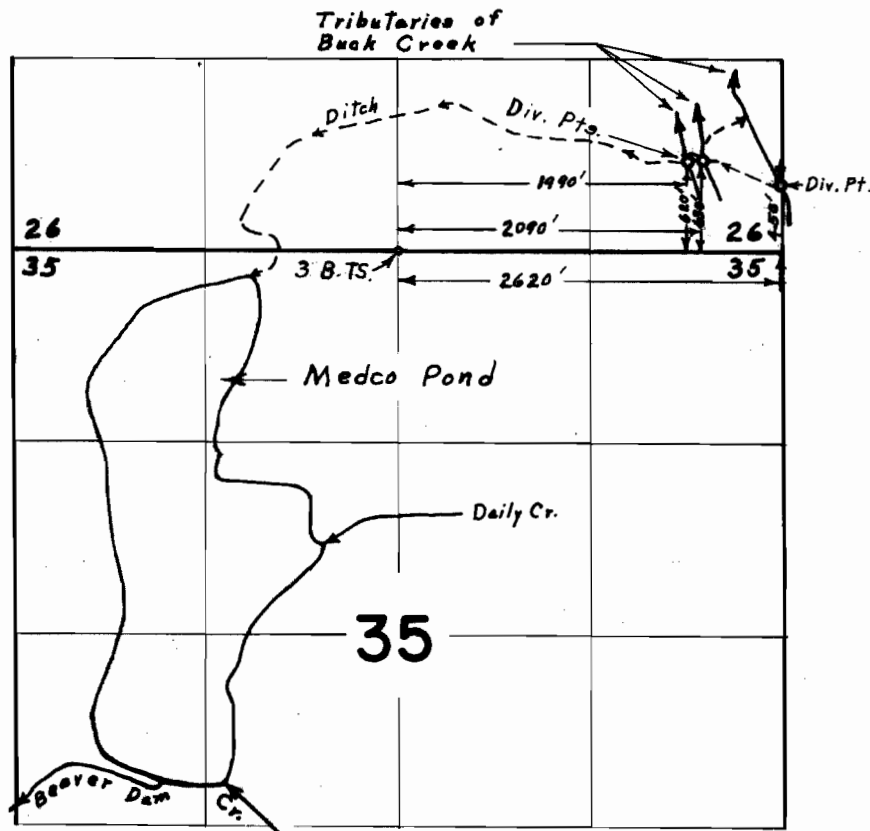

FINAL PROOF SURVEY
UNDER

Application No. 40217 Permit No. 22997
IN NAME OF

OREGON STATE GAME COMMISSION

Surveyed May 14, 1968, by L. E. Gould