


T. 34 S. R. 4 W. W.M.

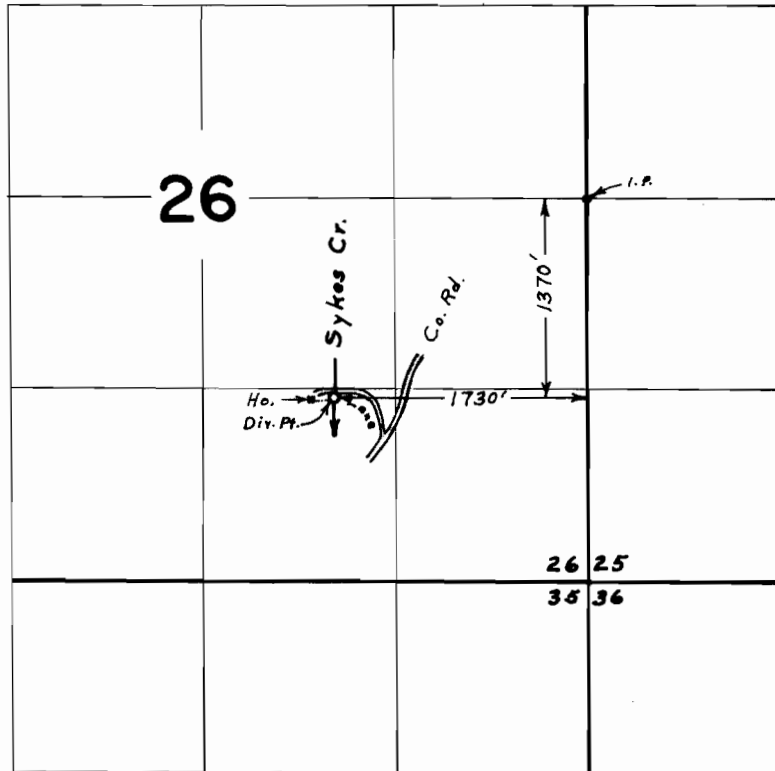

FINAL PROOF SURVEY
UNDER

Application No. 40257 Permit No. 30015
IN NAME OF
ESTHER WAGNER

Surveyed May 21, 1968, by L. E. Gould