


T. 36S. R. 3 W. W.M.

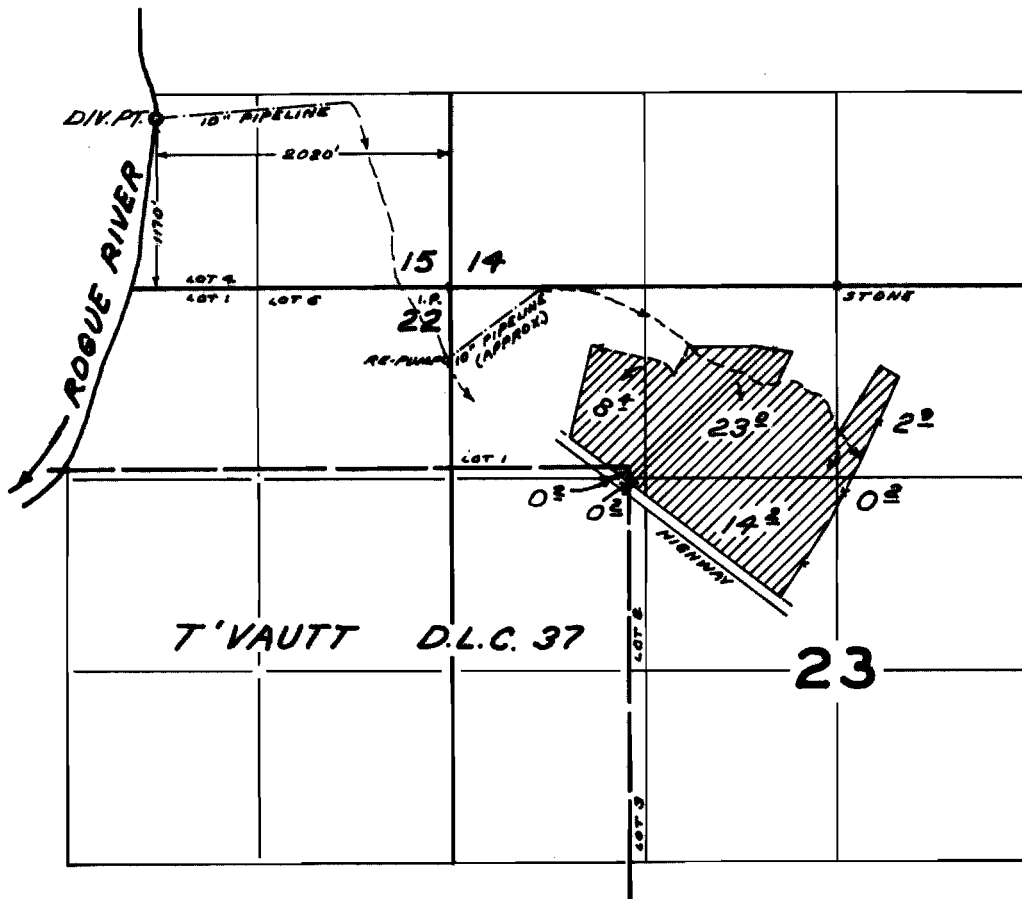

FINAL PROOF SURVEY
UNDER

Application No. 40863 Permit No. 30462
IN NAME OF

CHAYNER THOMPSON

Surveyed JUN 11 1968, by V. GARNER