


T. 34 S. R. 4 W W.M.

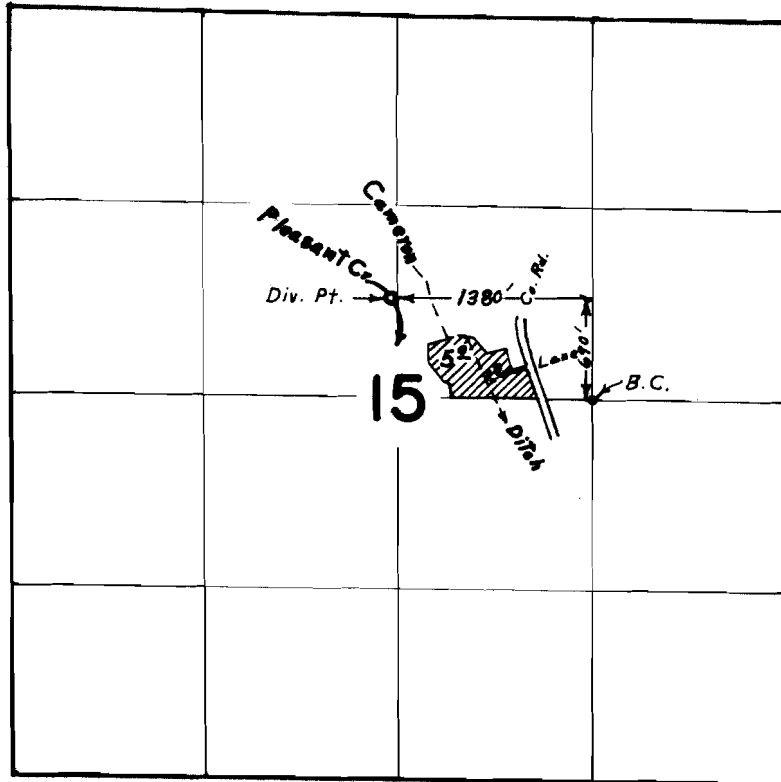

FINAL PROOF SURVEY UNDER

Application No. 40865 Permit No. 30464
IN NAME OF

ROBERT L. SHAFFER

Surveyed May 22, 1968, by L. E. Gould