


T. 36S. R. 4 W. W.M.

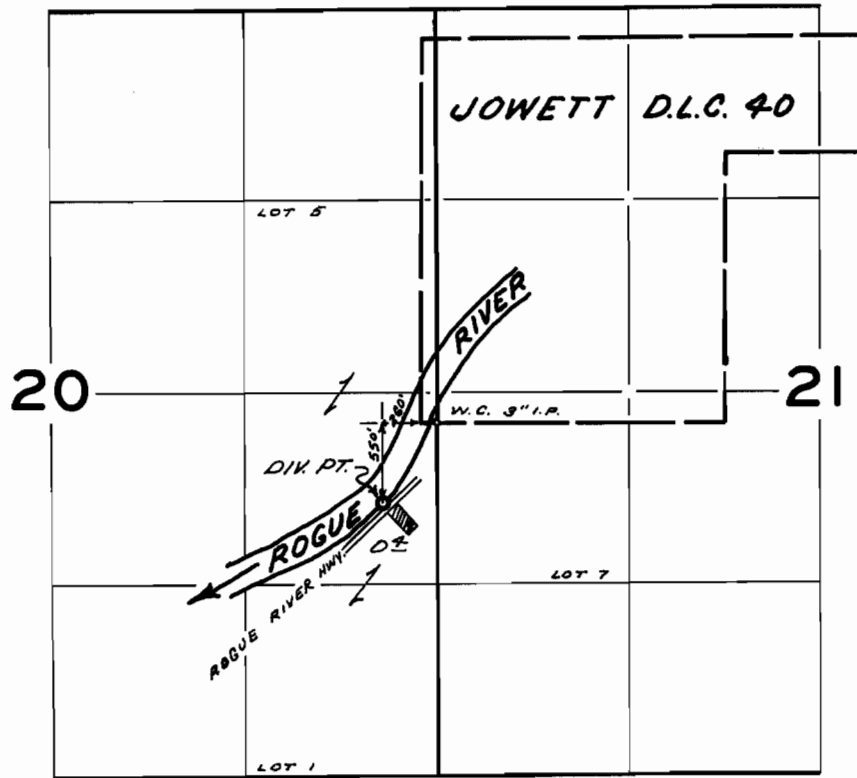

FINAL PROOF SURVEY
UNDER

Application No. 40998 Permit No. 30798
IN NAME OF

GUY F. DEAN

Surveyed JUN 4 1988, by V. GARNER