


T. 33 S. R. 2 E. W. M.

T. 32 S. R. 3 E. W. M.

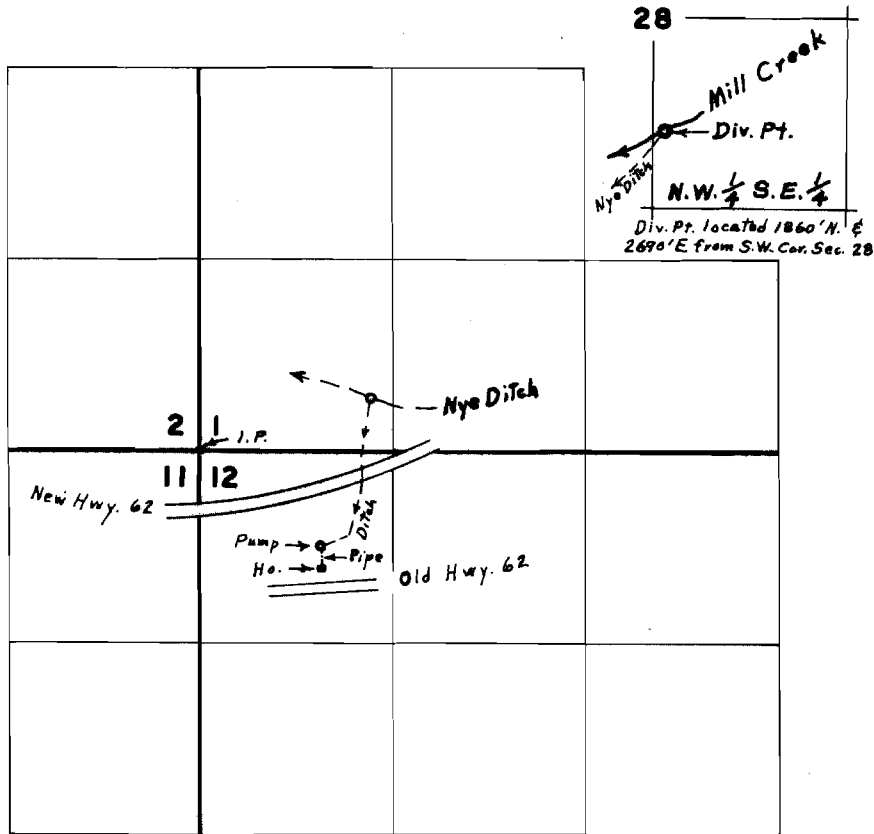

FINAL PROOF SURVEY UNDER

Application No. 42165... Permit No. 31554...
IN NAME OF

MRS. ELLEN ONN

Surveyed May 14, 1968., by L. E. Gould.