


T. 34 S. R. 1 W. W. M.

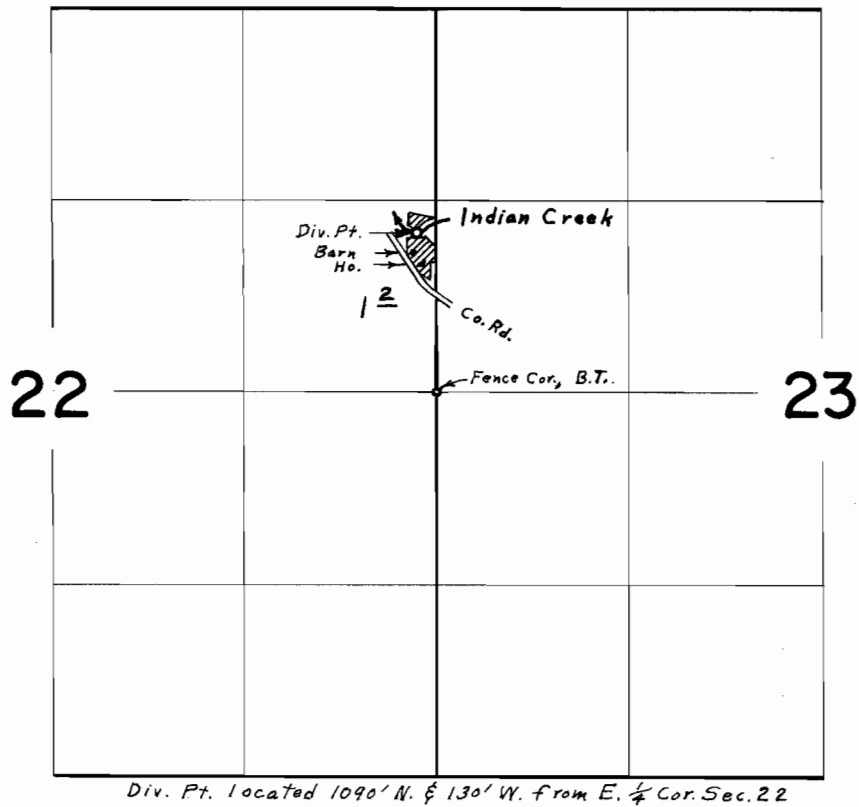

FINAL PROOF SURVEY
UNDER

Application No. 42349 Permit No. 31685
IN NAME OF
ROYCE COOLEY

Surveyed May 20, 1968, by L. E. Gould