


T.27S.R.23E.W.M.

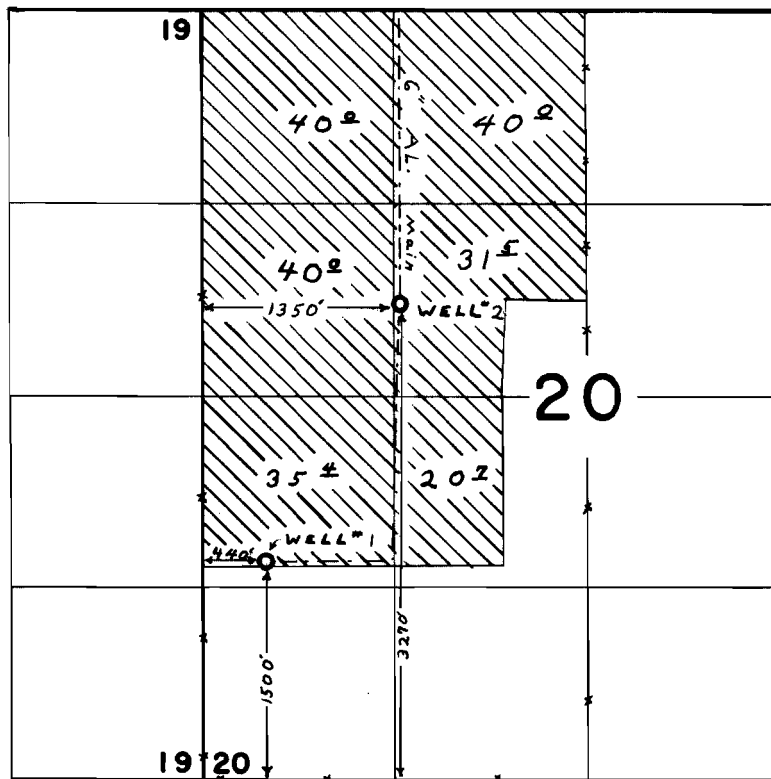

FINAL PROOF SURVEY
UNDER

Application No. G-2411... Permit No. G-2.23.2
IN NAME OF

.....SAM BOYCE.....

Surveyed AUG. 2... 1968, by L.E.GOULD...