


# T. 18 S. R. 2 & 3 W. W.M.

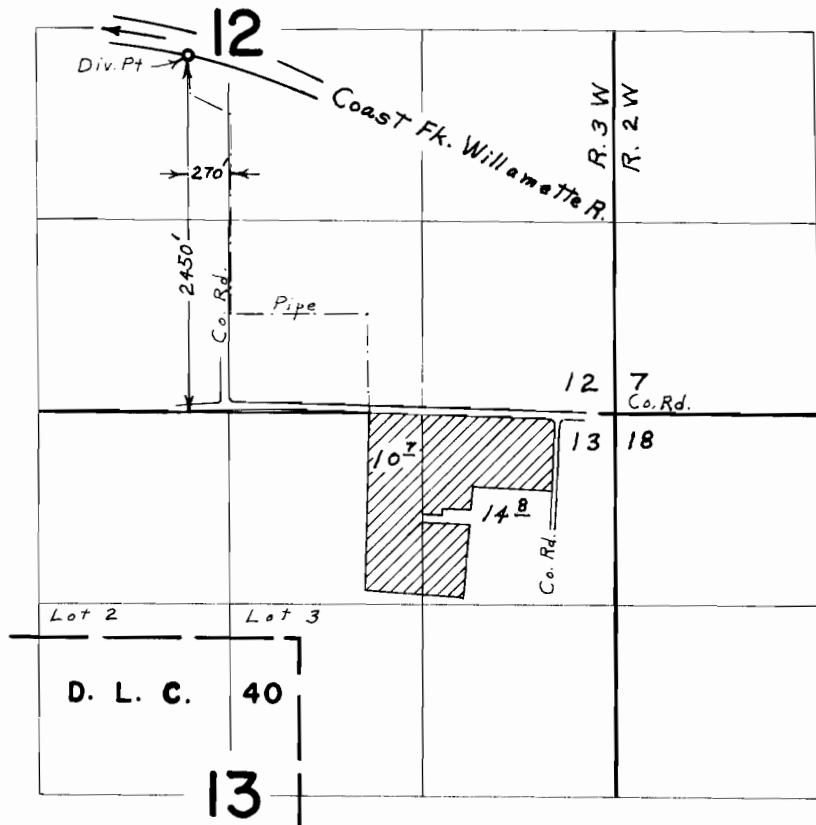

## FINAL PROOF SURVEY UNDER

Application No. 43242 Permit No. 32328  
IN NAME OF

**NORMAN R. EVONUK & JOHN C. JOHNSON**

Surveyed *June 25, 1968*, by *L. E. Gould*