


T. 18 S. R. 2 W. W.M.

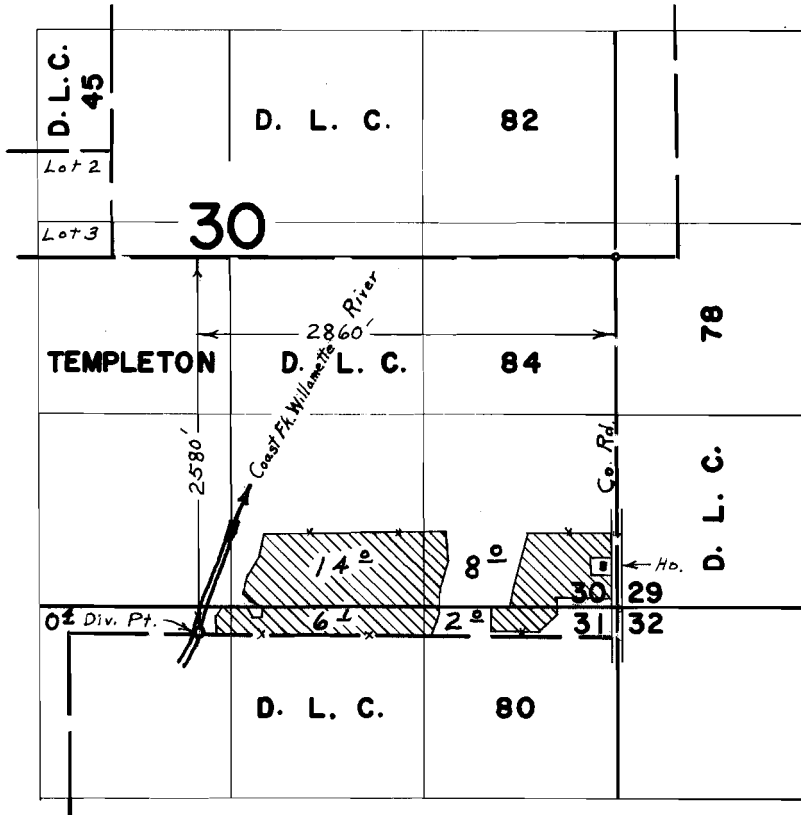

FINAL PROOF SURVEY UNDER

Application No. 39946 Permit No. 30043
IN NAME OF

FLOYD J. LEWIS

Surveyed June 26 1968, by L. E. Gould