


T. 22 S. R. 3 W. W. M.

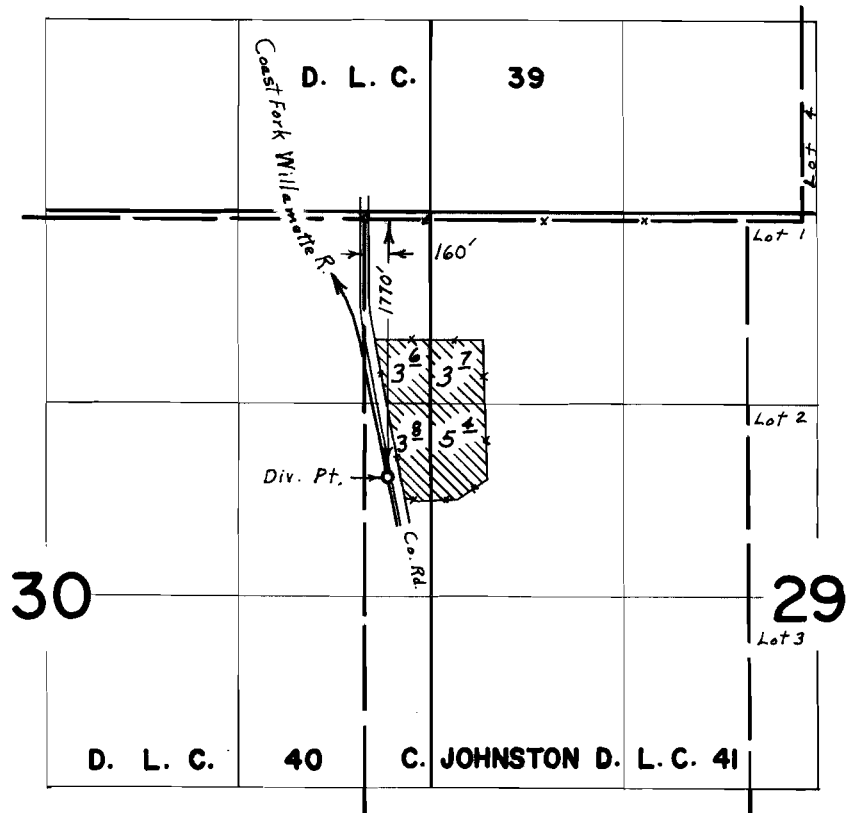

**FINAL PROOF SURVEY**  
UNDER

Application No. 40494 Permit No. 30173  
IN NAME OF  
**CARLTON DALE CHAMBERS, JR.**

Surveyed Sept. 22, 1967, by L. E. Gould