


T. 19 S. R. 3 W. W. M.

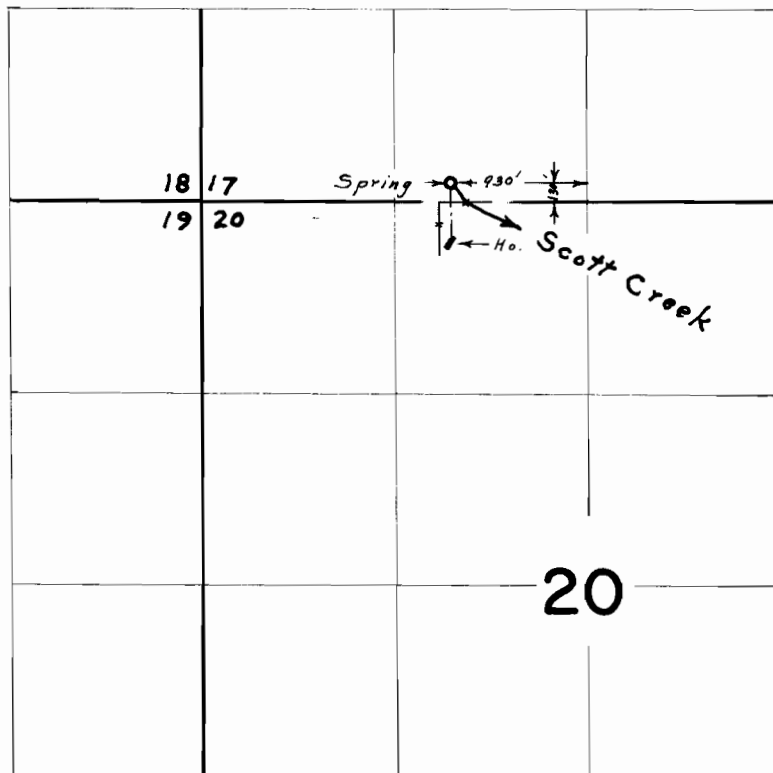

FINAL PROOF SURVEY
UNDER

Application No. 4/204 Permit No. 30811
IN NAME OF

MILTON B. & DEANNA L. OCUMPAUGH

Surveyed June 27 1968, by L. E. Gould