


T. 19 S. R. 3 W. W. M.

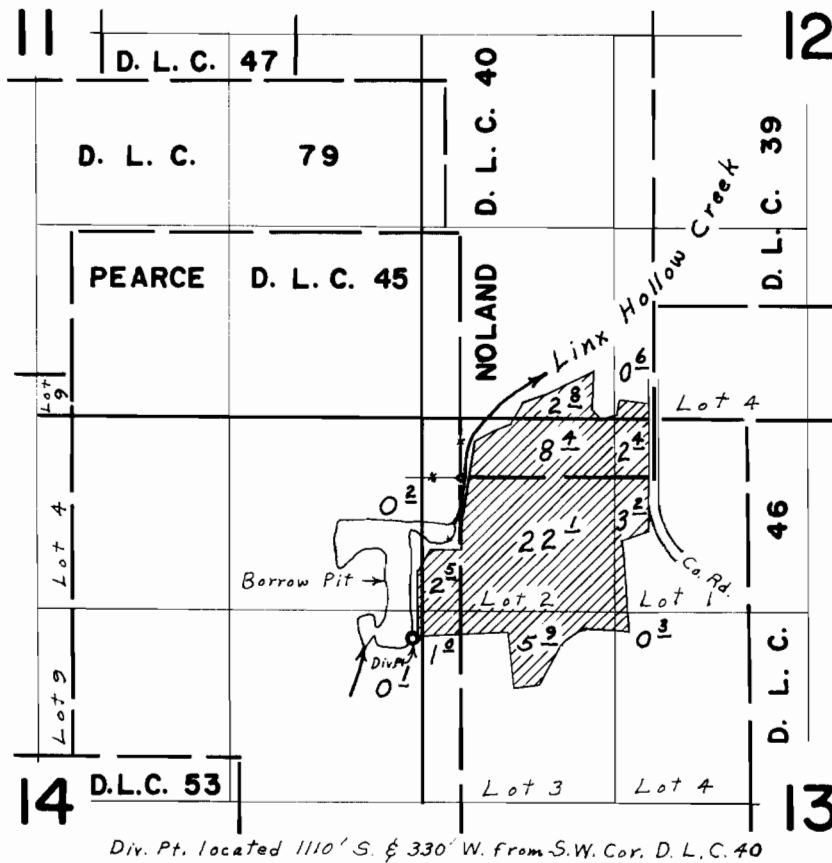

Div. Pt. located 1110' S. & 330' W. from S.W. Cor. D. L. C. 40

FINAL PROOF SURVEY UNDER

Application No. 41693 Permit No. 31133
IN NAME OF

DALE H. ZINIKER

Surveyed June 28 1968, by L. E. Gould