


T.14S. R.1W. W.M.

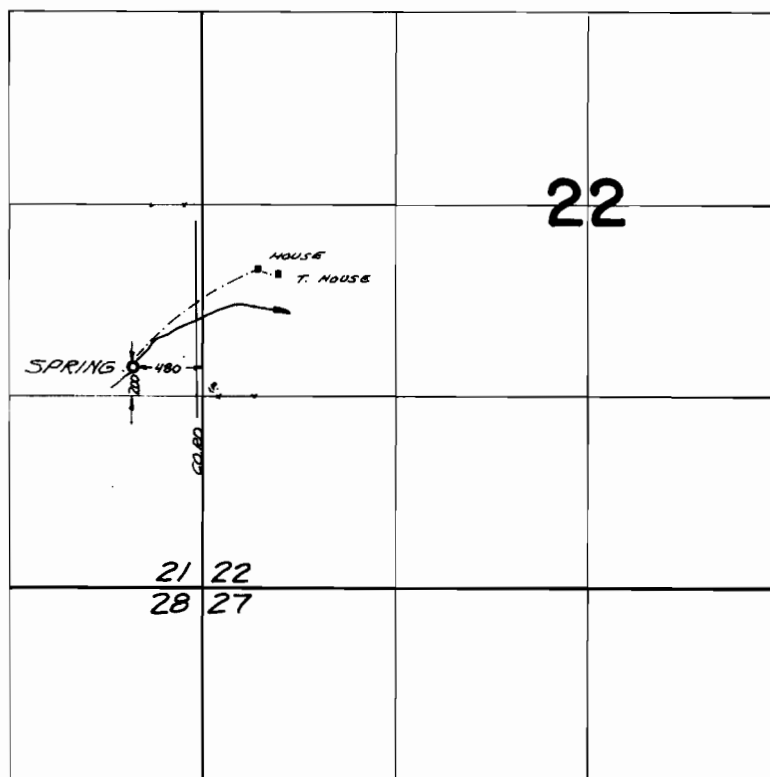

FINAL PROOF SURVEY
UNDER

Application No. 42251... Permit No. 31612...
IN NAME OF

ALBERT and NITA ABENROTH

Surveyed *Nov. 15, 1968*, by *V. Garner*