


T.7&8S.R.1W.W.M.

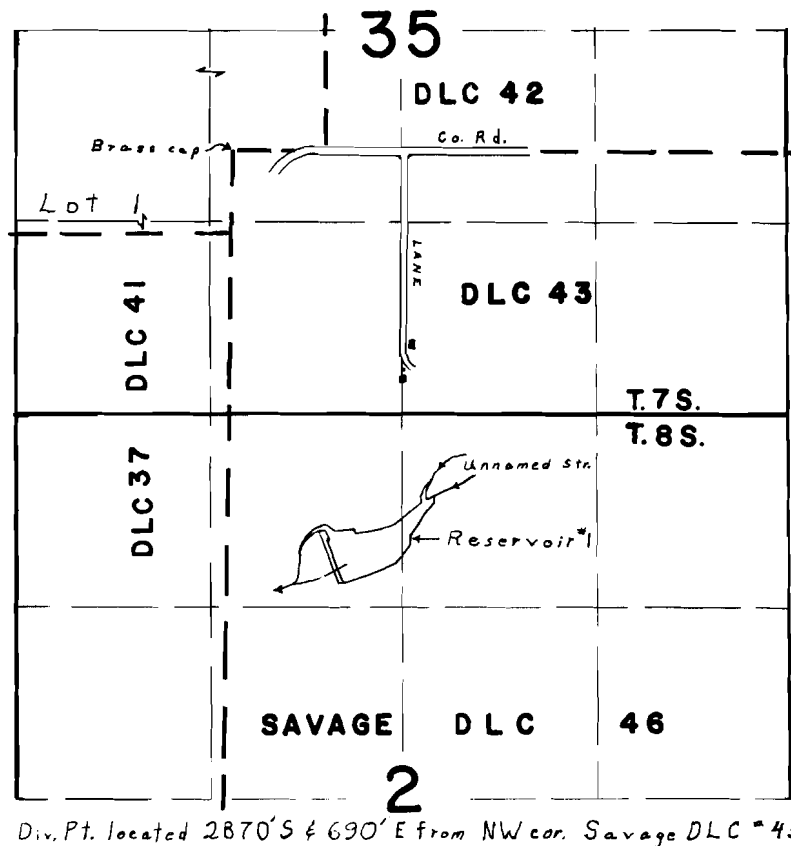

Div. Pt. located 2870'S & 690'E from NW cor. Savage DLC # 43

FINAL PROOF SURVEY
UNDER

R-38695 R-3978
Application No. 38696 Permit No. 29683
IN NAME OF

SAVAGE-MARTIN-SAVAGE

Surveyed **JULY 23 1968**, by **L. E. GOULD**