


T. 6 S. R. 1 W. W. M.

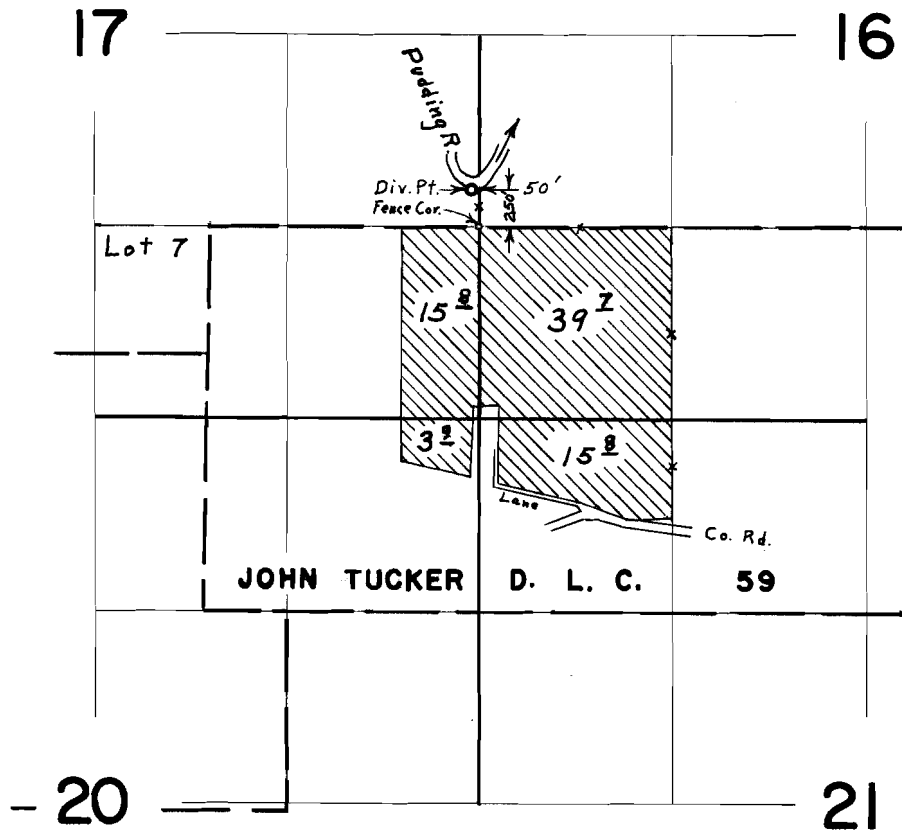

FINAL PROOF SURVEY
UNDER

Application No. 40248 Permit No. 30009
IN NAME OF
WILMER P. GRUBER

Surveyed April 24, 1968, by L. E. Gould