


T. 6 S. R. 1 W. W. M.

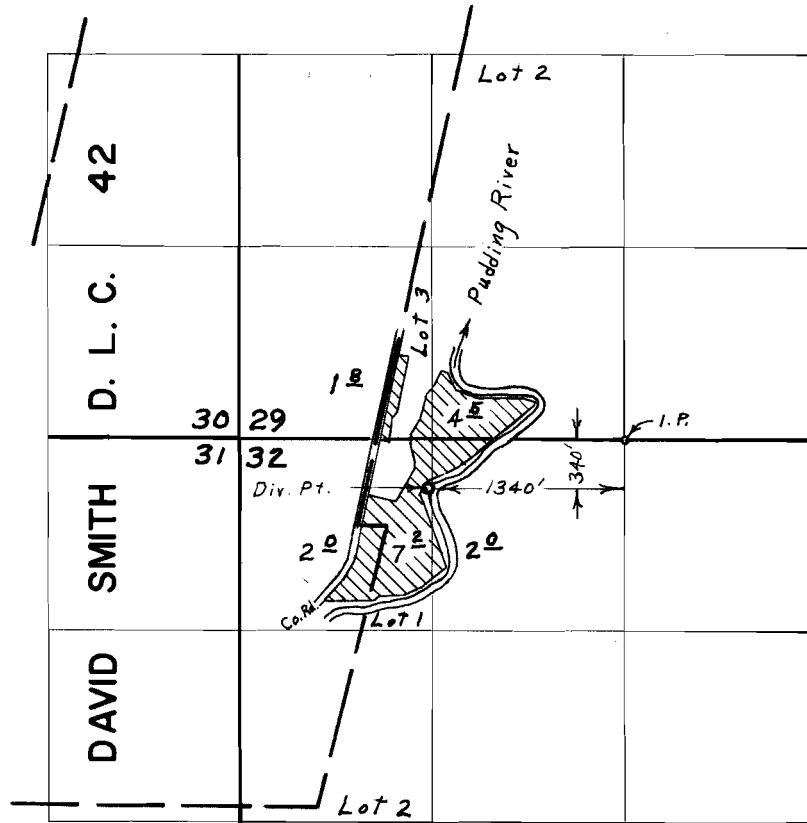

FINAL PROOF SURVEY UNDER

Application No. 40762 Permit No. 30355
IN NAME OF

V. NELSON HODGES & P. WAYNE HODGES

Surveyed April 26, 1968, by L. E. Gould