


T. 7 S. R. 1 W. W. M.

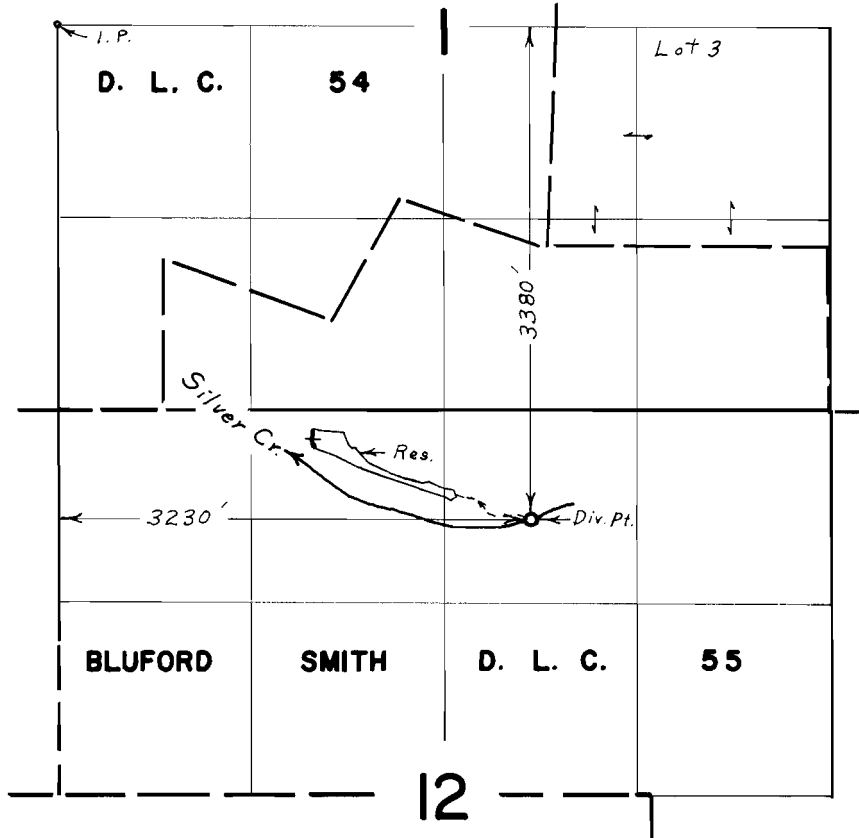

FINAL PROOF SURVEY UNDER

R-41230 *R-4656*
Application No. *41231* Permit No. *30827*
IN NAME OF

SHERRILL A. FUNRUE

Surveyed *May 10, 1968*, by *L. E. Gould*