


# T. 7 S. R. 1 W. W. M.

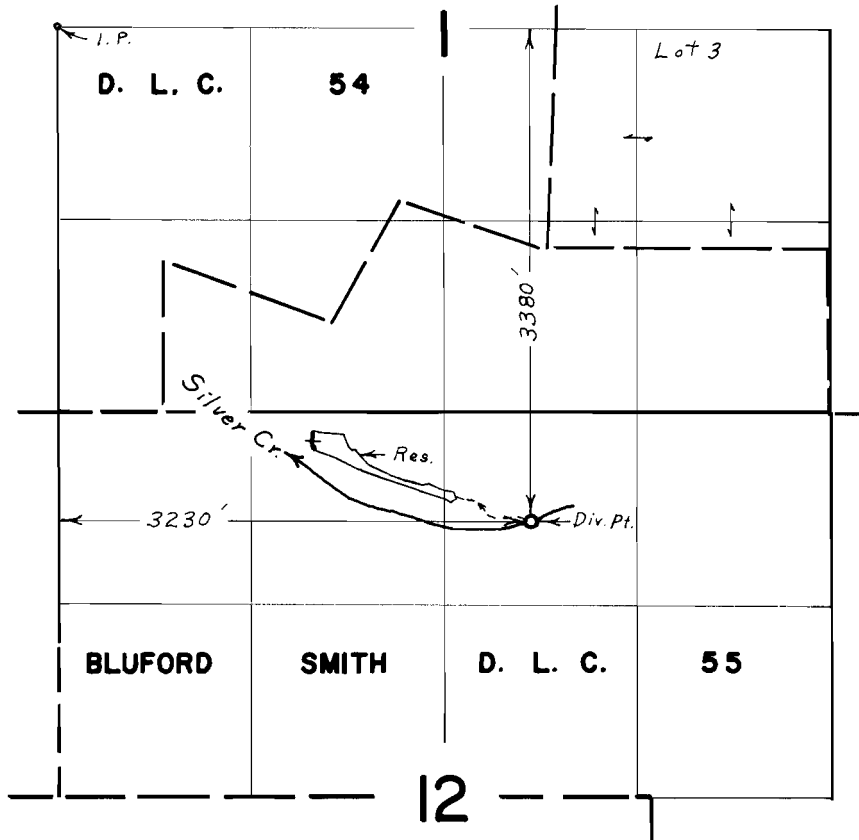

## FINAL PROOF SURVEY UNDER

*R-41230*                      *R-4656*  
Application No. *41231* Permit No. *30827*  
IN NAME OF

**SHERRILL A. FUNRUE**

Surveyed *May 10, 1968*, by *L. E. Gould*