


T. 7 S. R. 1 W. W. M.

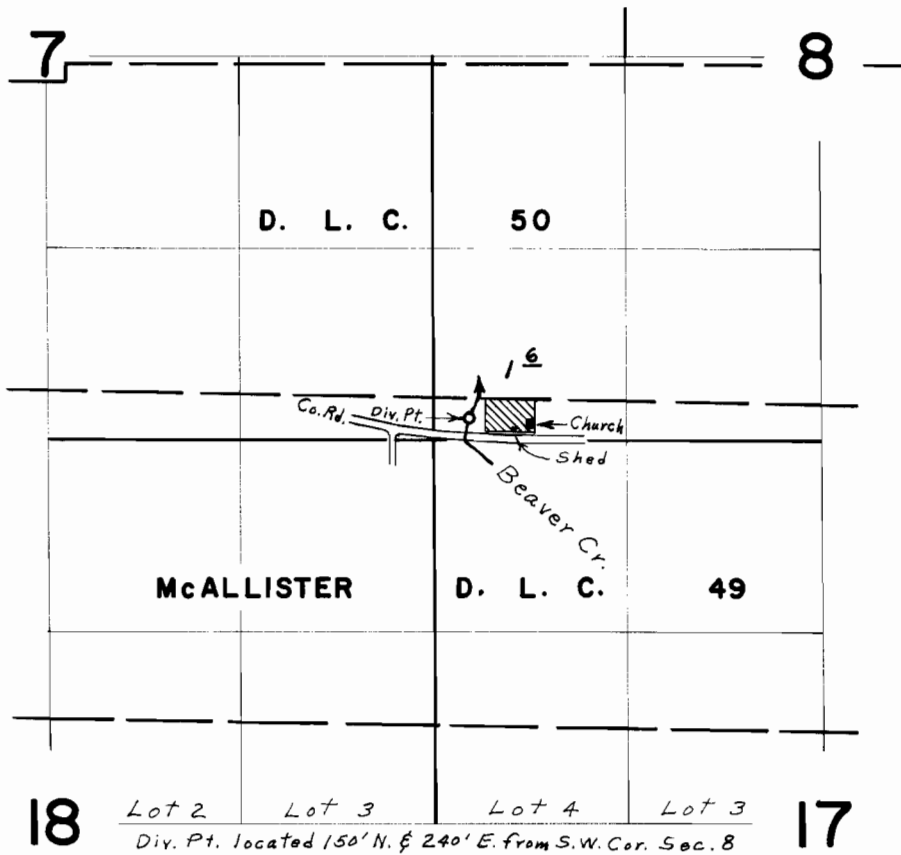

FINAL PROOF SURVEY UNDER

Application No. 42649 Permit No. 31397
 IN NAME OF
**THE GERMAN
 APOSTOLIC CHRISTIAN CHURCH**

Surveyed May 29 1968, by L. E. Gould