


# T.5N.R.29E.W.M.

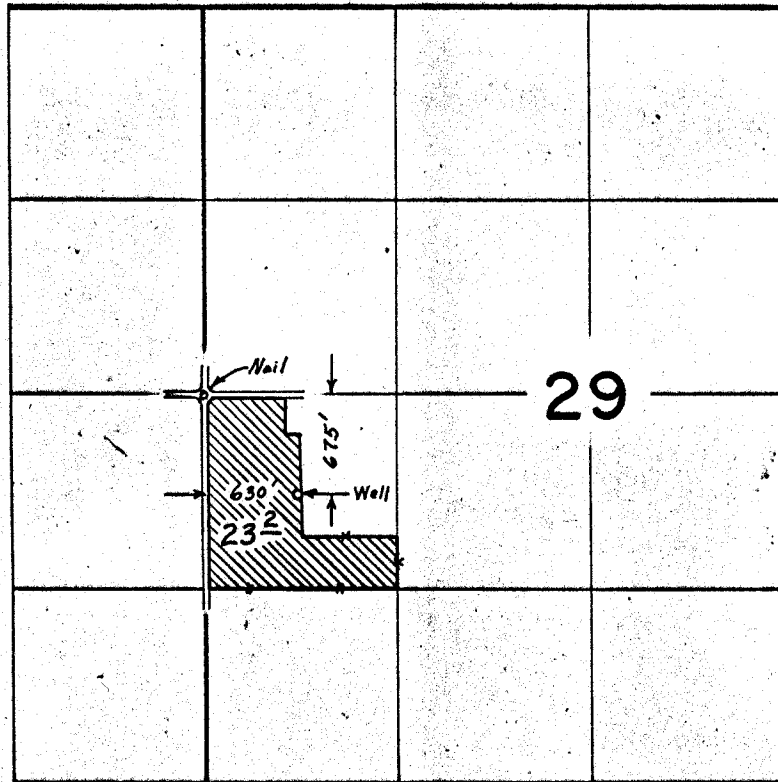

## FINAL PROOF SURVEY UNDER

Application No. ~~G-2567~~ Permit No. ~~G-2376~~  
IN NAME OF

**MARION R. CHAVES**

Surveyed *June 23, 1967.*, by *L. E. Gould*.....