


T.2N.R.4W.W.M.

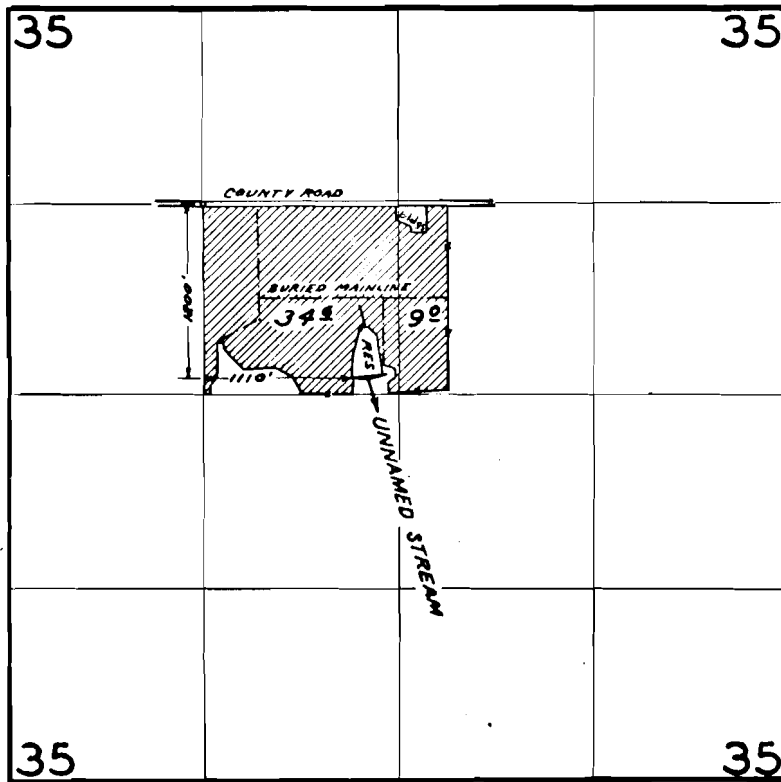

FINAL PROOF SURVEY
UNDER

Application No. 40571 Permit No. 30230
R-90570 R-4539
38114 28407
R-38113 R-3157

IN NAME OF

DUANE SPIERING

Surveyed MAY 11 1967, by V. GARNER