


T.5S.R.3W.W.M.

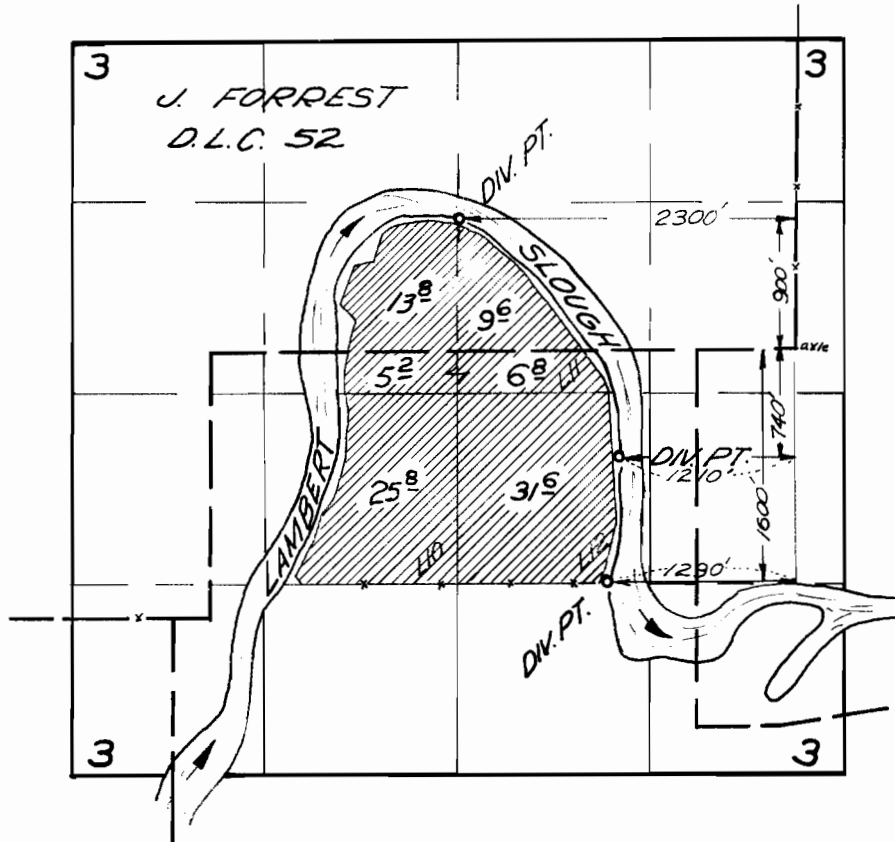

Note: 84[±] acres previously allowed under Cert. 13992

FINAL PROOF SURVEY UNDER

Application No. 37184 Permit No. 27688.
IN NAME OF

U.S. ALDERMAN

Surveyed Oct. 18, 1966, by V. GARNER.....