


T.5S.R.38&4W.W.M.

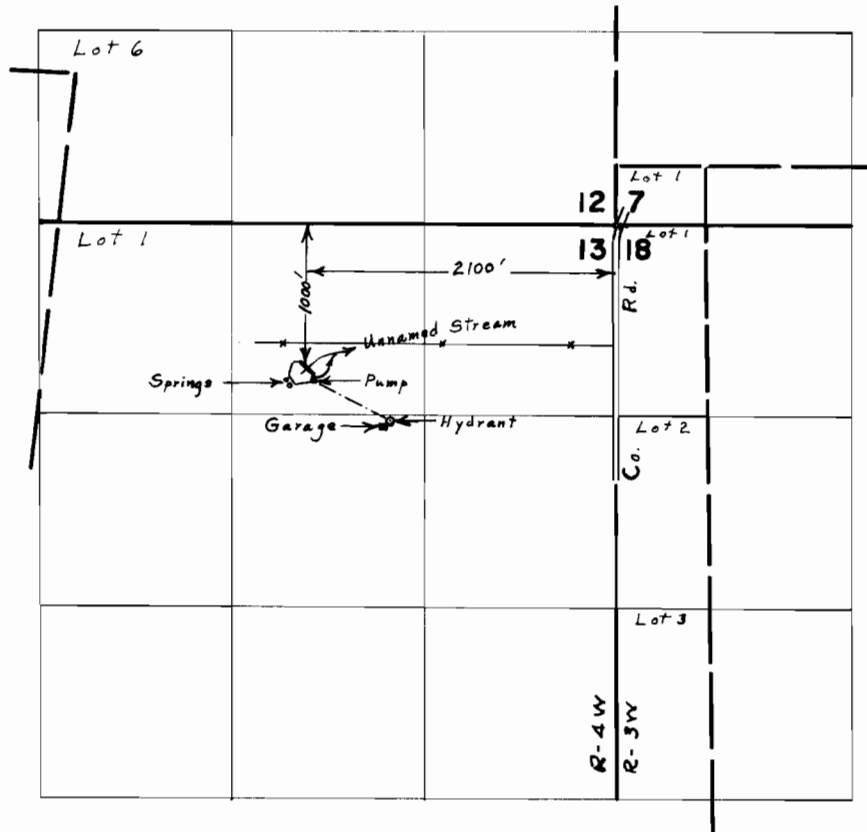

FINAL PROOF SURVEY UNDER

R-38121 R-3515
Application No. 38122 Permit No. 28985
IN NAME OF

ROBERT CALLANDER

.....
Surveyed April 20, 1967, by L. E. Gould