


T.5S.R.3W.W.M.

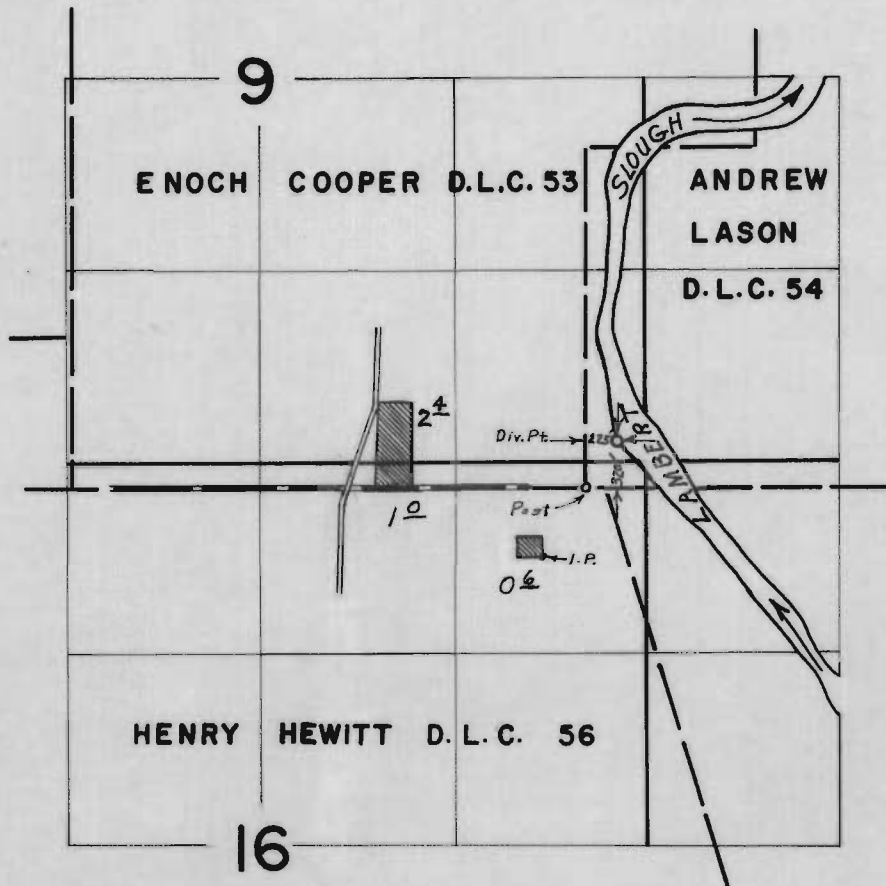

FINAL PROOF SURVEY UNDER

Application No. 41043. Permit No. 30636.
IN NAME OF
LEO EISELSTEIN

Surveyed April 17, 1967, by L. E. Gould