


T.11S.R.4W.W.M.

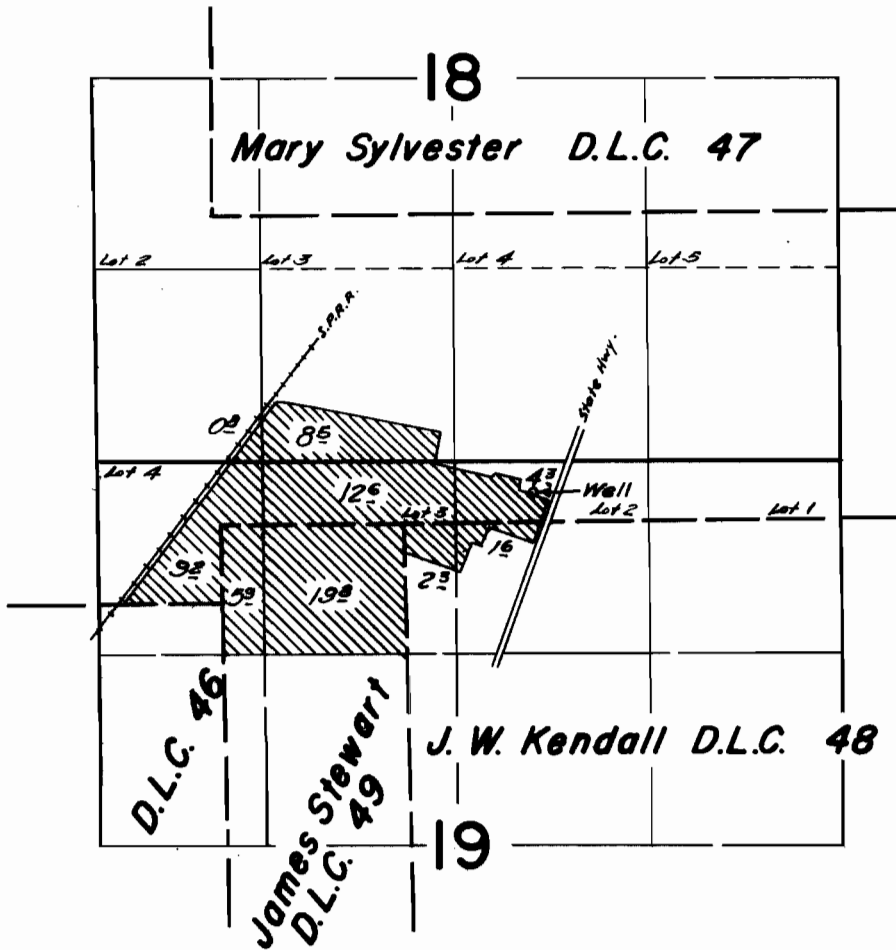

FINAL PROOF SURVEY UNDER

Application No. G-2581 Permit No. G-2393
IN NAME OF

ALLEN L. GUERBER

Surveyed Nov. 13 1963, by R. Jackson