


T.12 S. R.5 W. W.M.

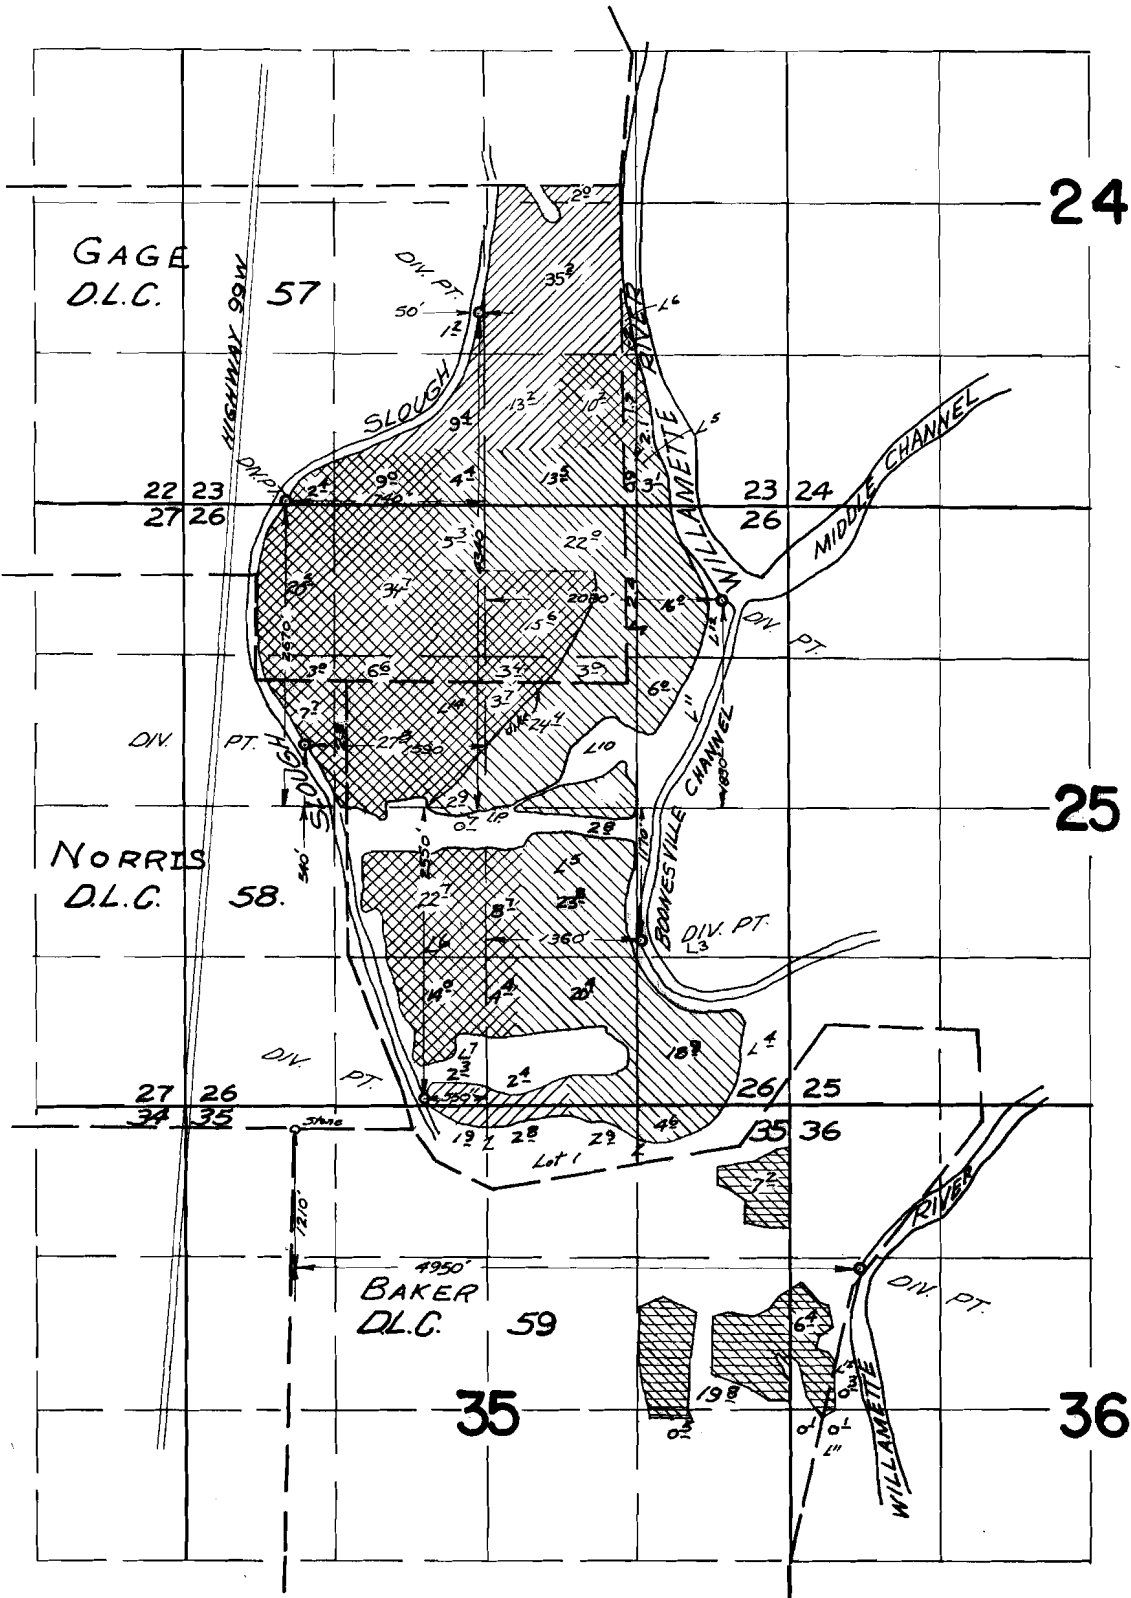

FINAL PROOF SURVEY UNDER


Application No. 34839 Permit No. 27350

IN NAME OF
C. E. JONES

Surveyed April 27, 1966 by V. Garner


DFJ-SP-52
1966-A

 WILLAMETTE

 SLOUGH



Willamette supplemental to slough



Willamette supplemental to Well