


C22160
35902

T. 17S. R. 20E. W.M.

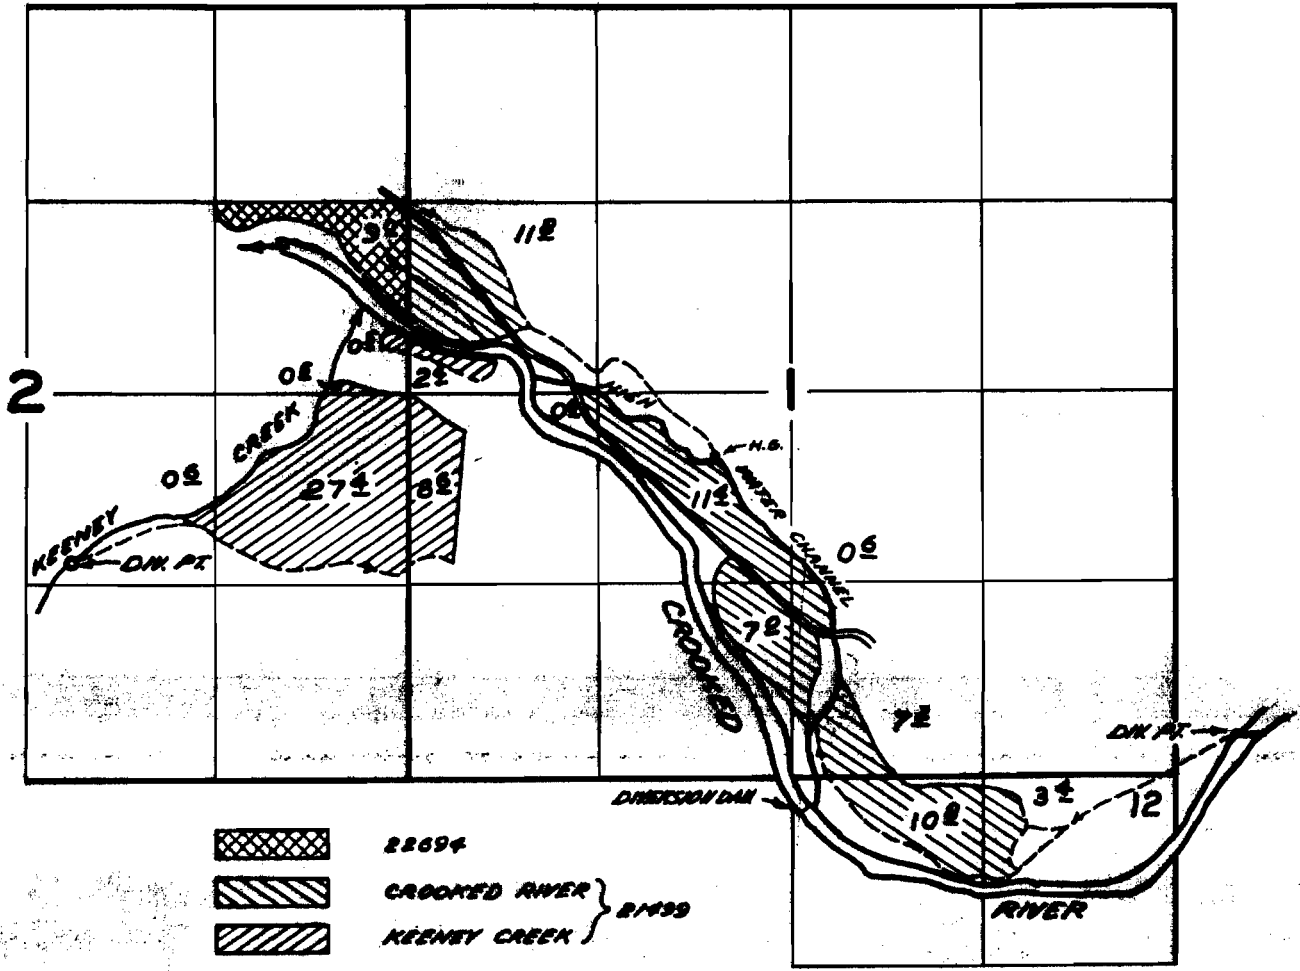

FINAL PROOF SURVEY UNDER

Application No. ~~21199~~ ²²⁶⁹⁴ Permit No. ~~16062~~ ¹⁷⁸⁹⁵
IN NAME OF

F. S. McCULLOUGH

Surveyed APR. 25, 1955, by T. Jones

DEC-21-1955-12N-195

16862