


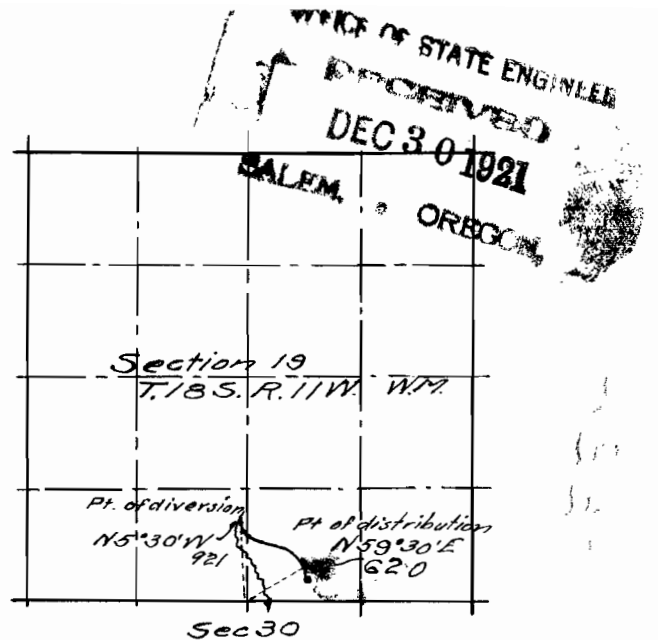

MAP SHOWING
POINT OF DIVERSION
POINT OF DISTRIBUTION
and
LOCATION of PIPELINE
in Sec 19, T. 18 S. R. 11 W. W.M.
WATER RIGHT for
FRANK SAUBERT
Scale 2" = 1 mi. Dec 1921.

Application No. 8224
Permit No. 5323