


# T. 6 S. R. 1 W. W. M.

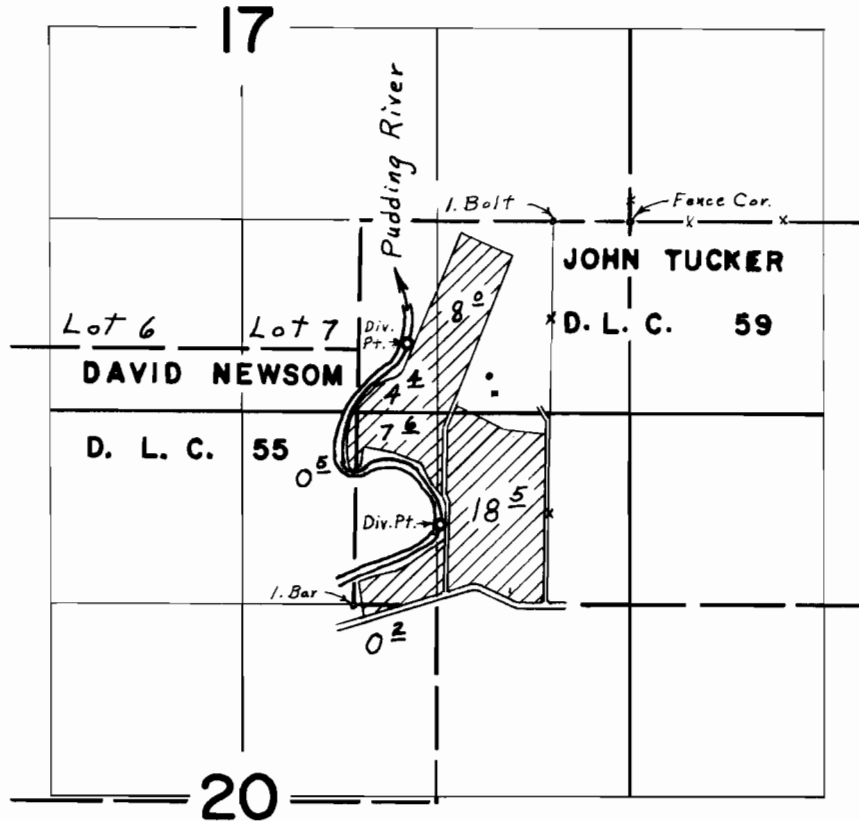

## FINAL PROOF SURVEY UNDER

Application No. 18840 Permit No. 14475  
IN NAME OF

**OLE SATERN**

Surveyed July 3, 1942, by Geo. V. Naderman