


T.4S. R.1W. W.M.

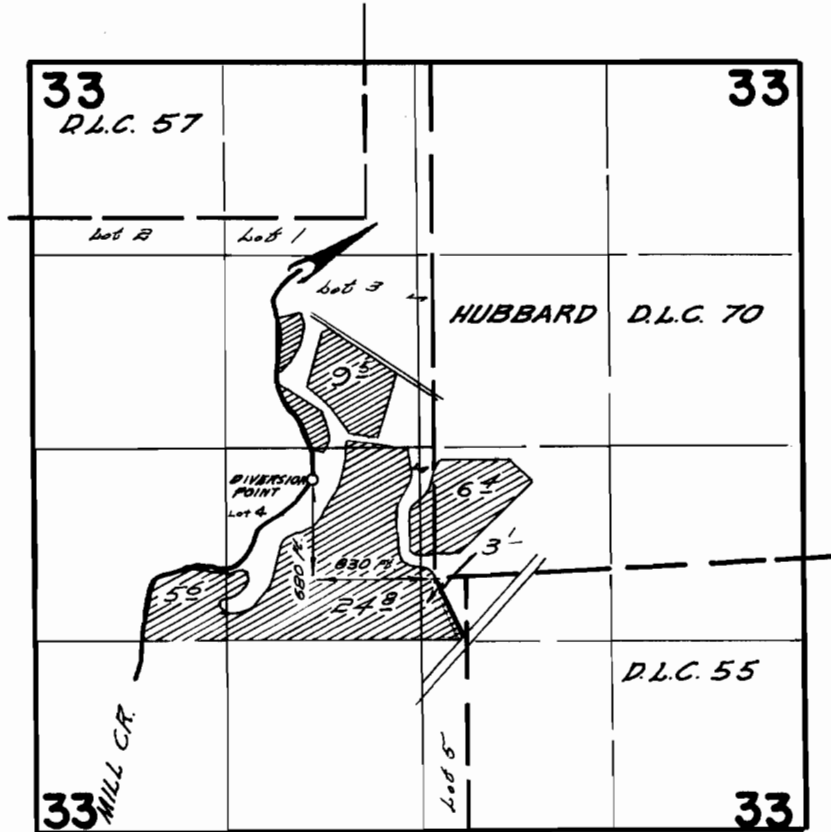


FINAL PROOF SURVEY  
UNDER

Application No. 25657 Permit No. 20116  
IN NAME OF

*MIKE BRONEC*

Surveyed Sept. 7, 1956, by *M. Bish*

T. 4S. R. 1W. W.M.

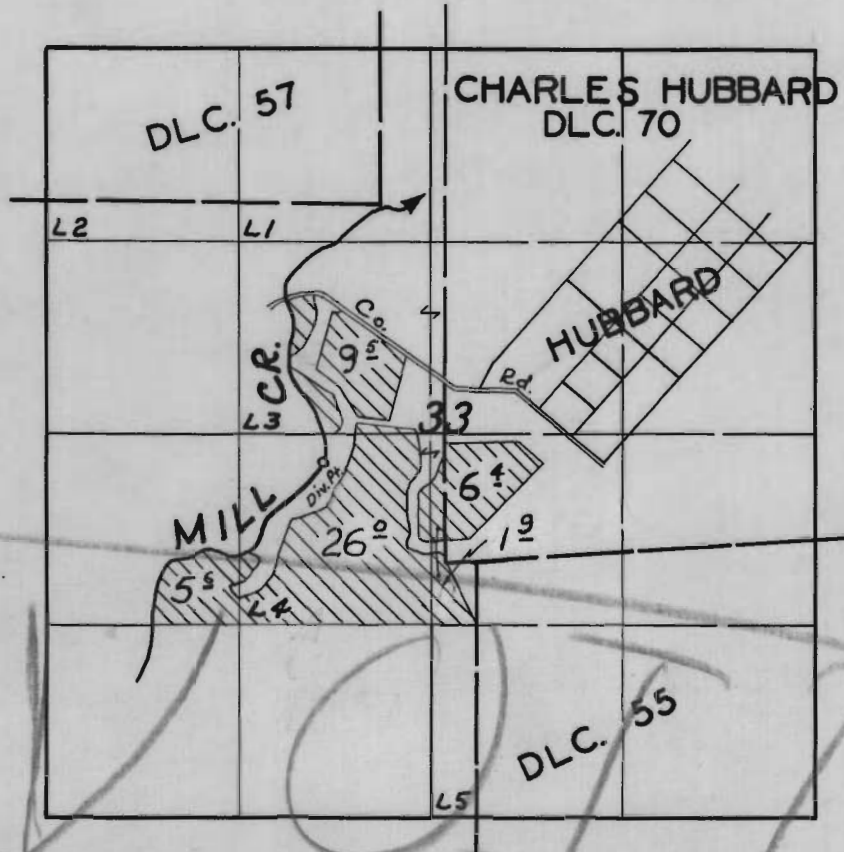

**FINAL PROOF SURVEY**

UNDER

Application No. 25651. Permit No. 20116

IN NAME OF

**MIKE BRONEC**

Surveyed 7 SEPT. 1956, by M. BISH

DFN-2D-211

Box