


T.37&38S.R.5W.W.M.

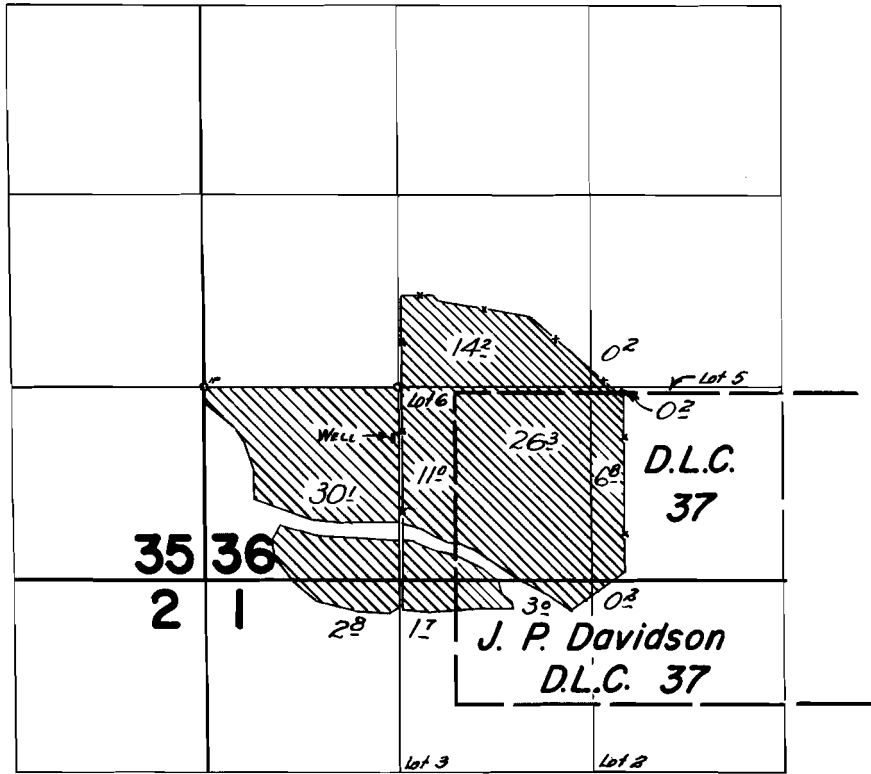

FINAL PROOF SURVEY  
UNDER

Application No. G-1986 Permit No. G-1828...  
IN NAME OF

JACK BENNETT

Surveyed July 16 1963, by *[Signature]*