


# T. 1N. R. 3W. W.M.

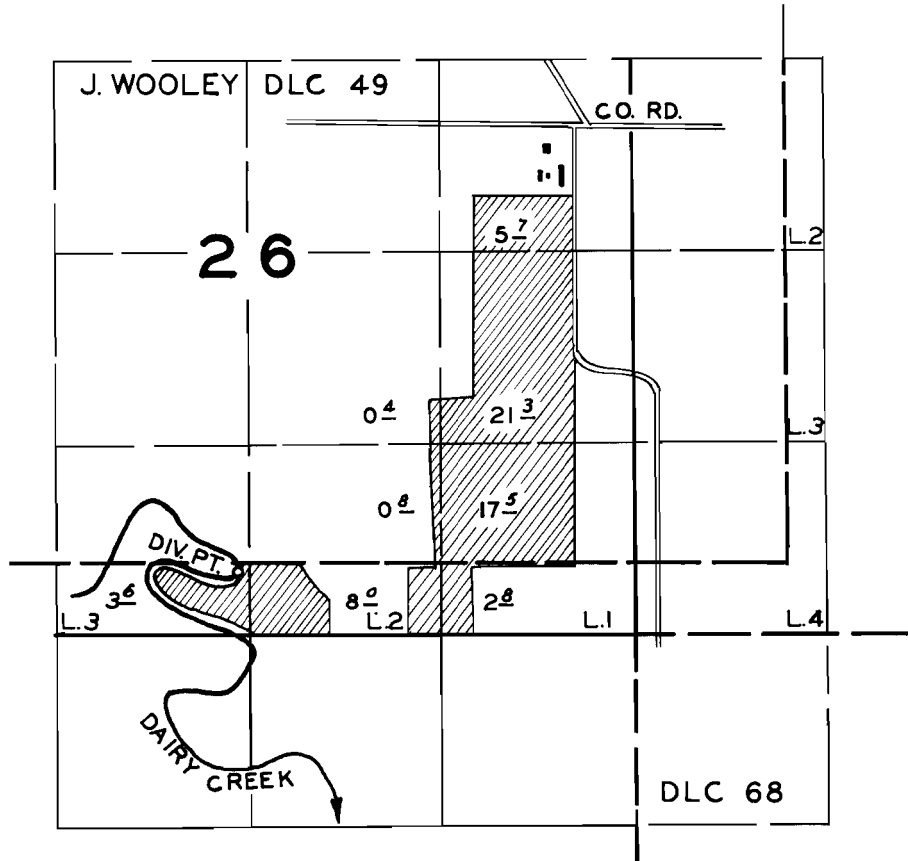

## FINAL PROOF SURVEY UNDER

Application No. 30639 Permit No. 24138  
IN NAME OF

**JOHN W. GATES**

Surveyed SEPT. 8 1960, by R.H. JACKSON