


T.5S.R.10W.W.M.

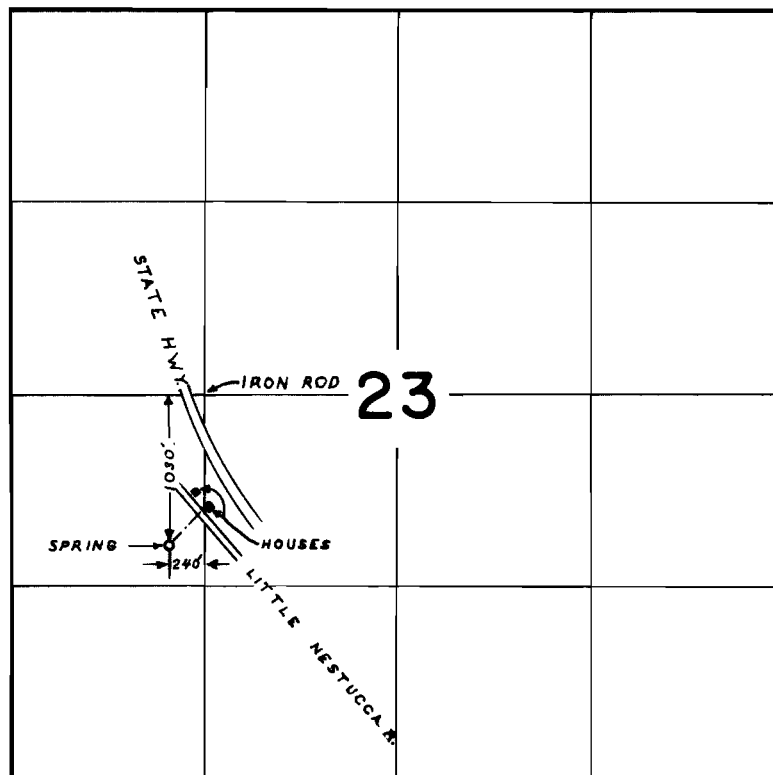

FINAL PROOF SURVEY
UNDER

Application No. **21595** Permit No. **16968**
IN NAME OF

A. H. FOX

Surveyed **OCT. 2 1968** by **L. E. GOULD**