


T.14S.R.5W. W.M.

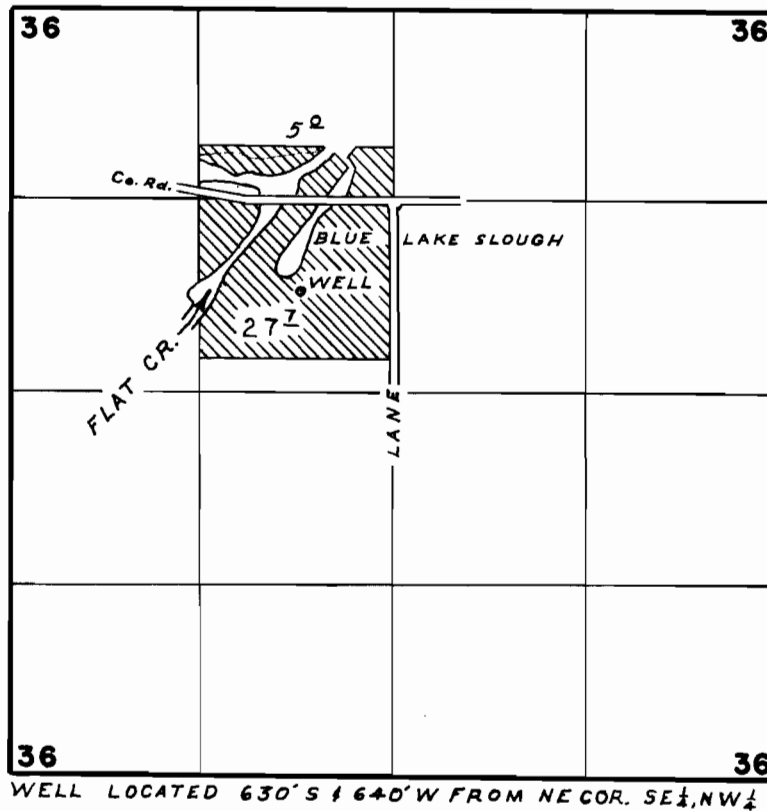

FINAL PROOF SURVEY
UNDER

Application No. G-2635 Permit No. G-2442
IN NAME OF

RALPH and NICA MCGEE

Surveyed SEPT. 26 1968, by L. E. GOULD