


T. 28 S. R. 14 W. W.M.

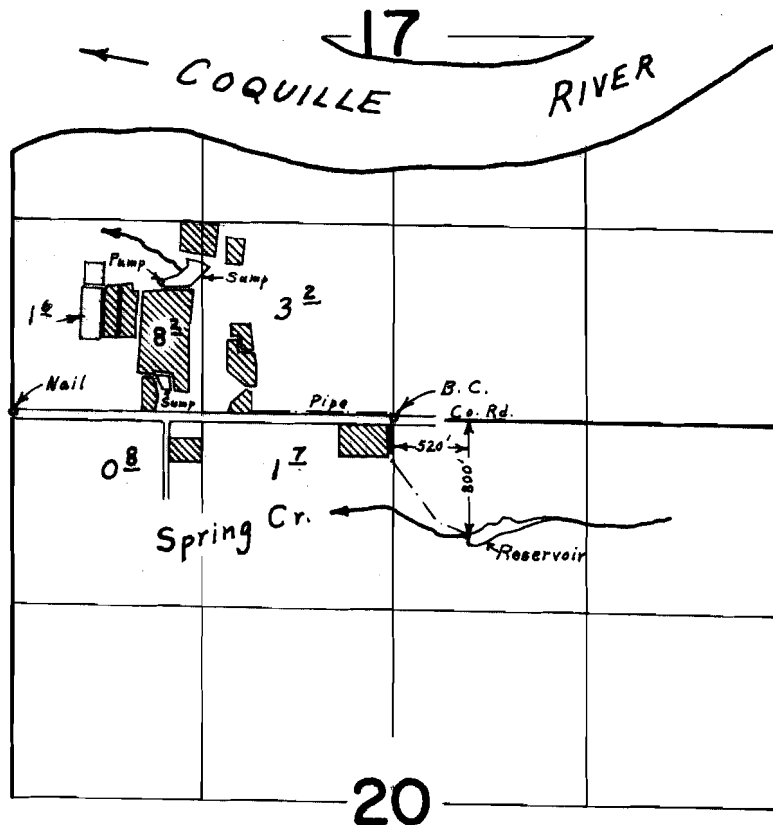

FINAL PROOF SURVEY
UNDER

Application No. 42041... Permit No. 31470...
IN NAME OF

W. W. SHERERTZ & ROGER S. WINTERS

Surveyed July 12, 1968, by L. E. Gould