


T. 33 S. R. 6 W. W. M.

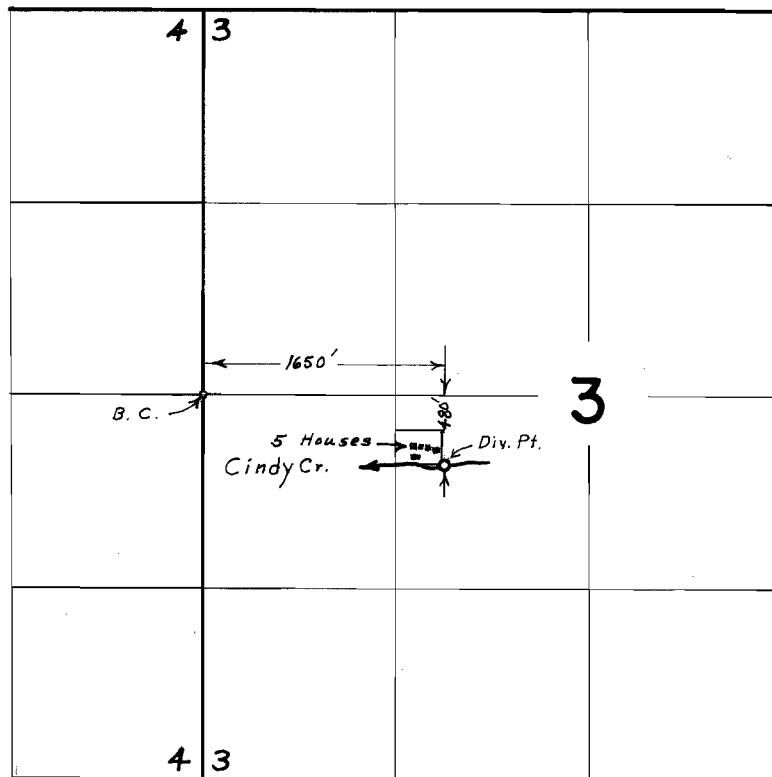

FINAL PROOF SURVEY
UNDER

Application No. 42903 Permit No. 32061
IN NAME OF

EDWARD W. OPPERMAN

Surveyed May 3, 1968, by L. E. Gould