


P-23605
35944

T.9S. R.27E.W.M.

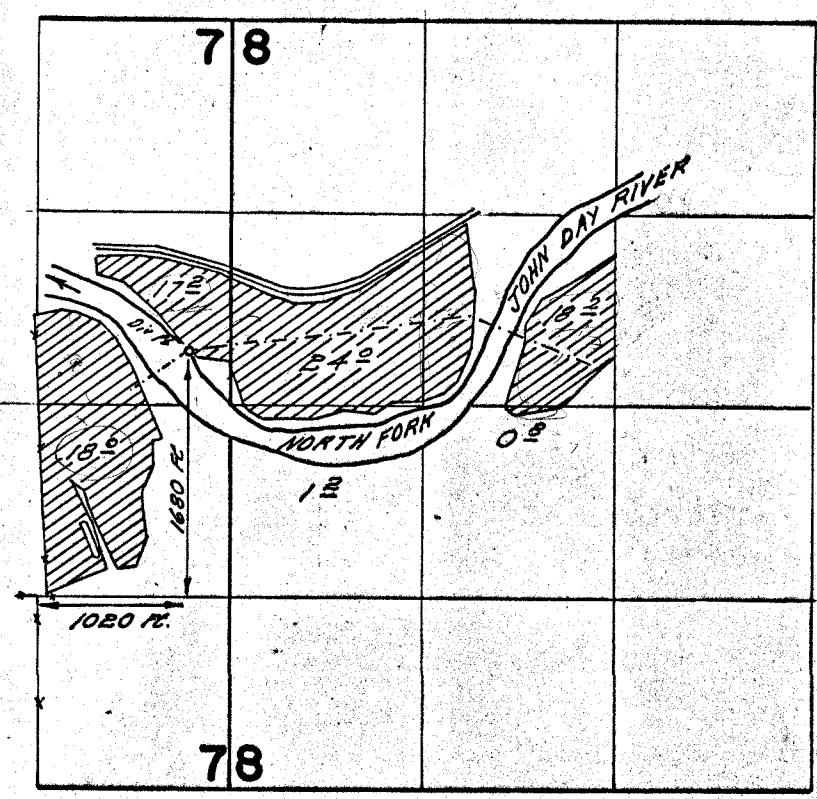

FINAL PROOF SURVEY UNDER

Application No. *29964* Permit No. *23605*
IN NAME OF

W & E MILLER RANCHES, INC.

Surveyed *Nov. 14, 1962* by *R. JACKSON*
May 14, 1968 by *W. J. Fuppert*

1968-A
1968-M