


P-28027
35946

T.10&11S.R.29E.W.M.

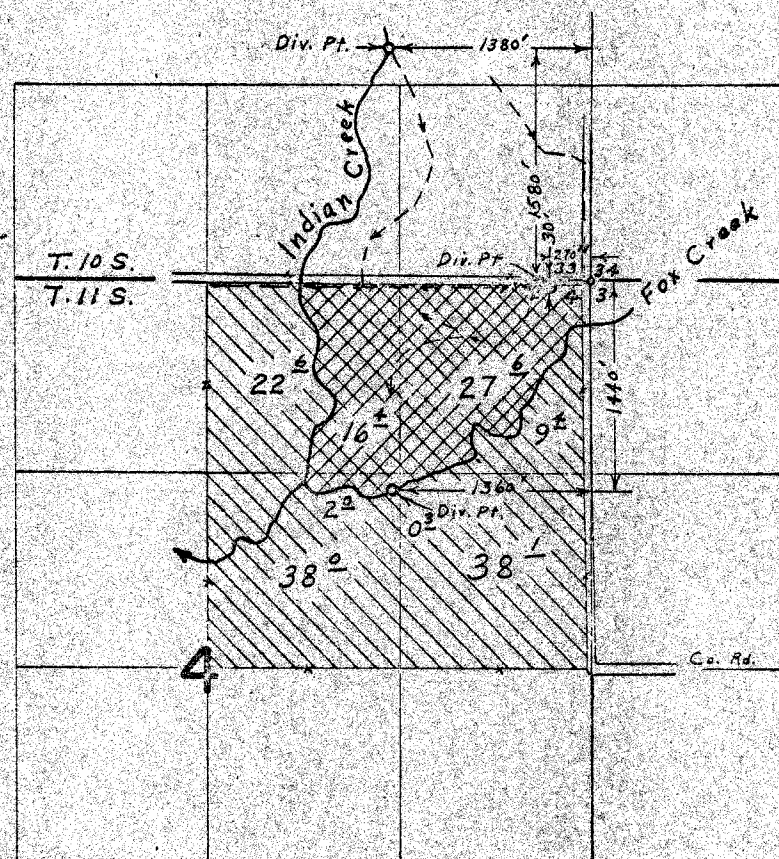

FINAL PROOF SURVEY
UNDER

37519 28027
Application No. 38641 Permit No. 28932
IN NAME OF
JACK E. JOHNS



Surveyed June 7, 1968, by L. E. Gould