


T.10 S.R.29 E.W.M.

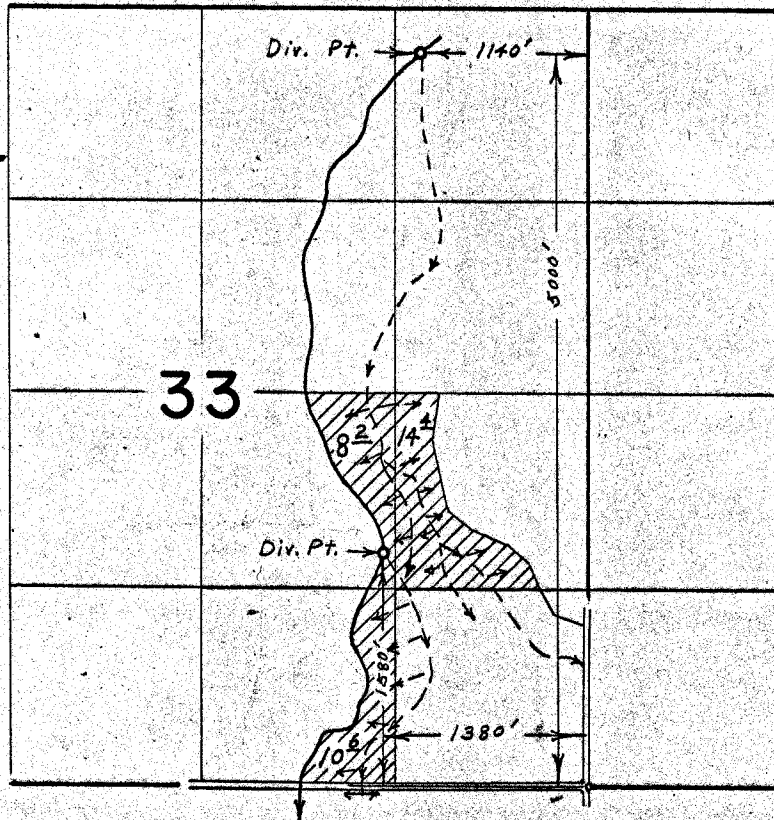

FINAL PROOF SURVEY

UNDER

Application No. 38640 Permit No. 28931
IN NAME OF

BERTHA JOHNS VAUGHAN RANCH

Surveyed June 7, 1968, by L. E. Gould