


P-29229

SEE T-2789

S.O. Vol. 31 P. 9 35950

T. 9 S. R. 27 E. W.M.

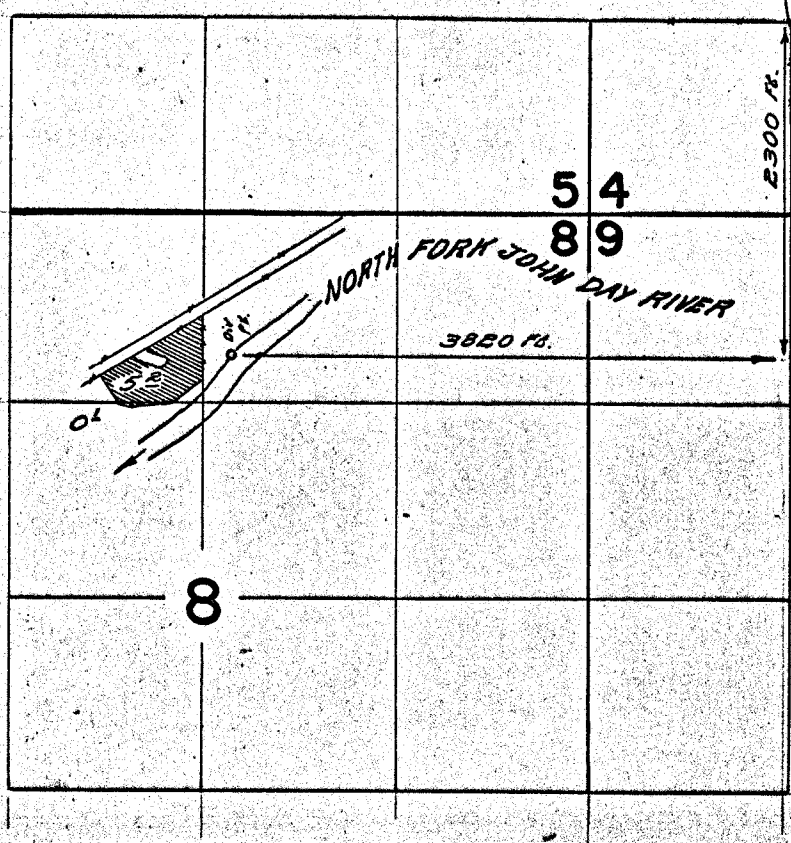

FINAL PROOF SURVEY UNDER

Application No. 39228. Permit No. 29229.
IN NAME OF

BEN M. SPAIN

Surveyed May 14, 1968, by W. J. Ruppert