


T.26S.R.34E.W.M.

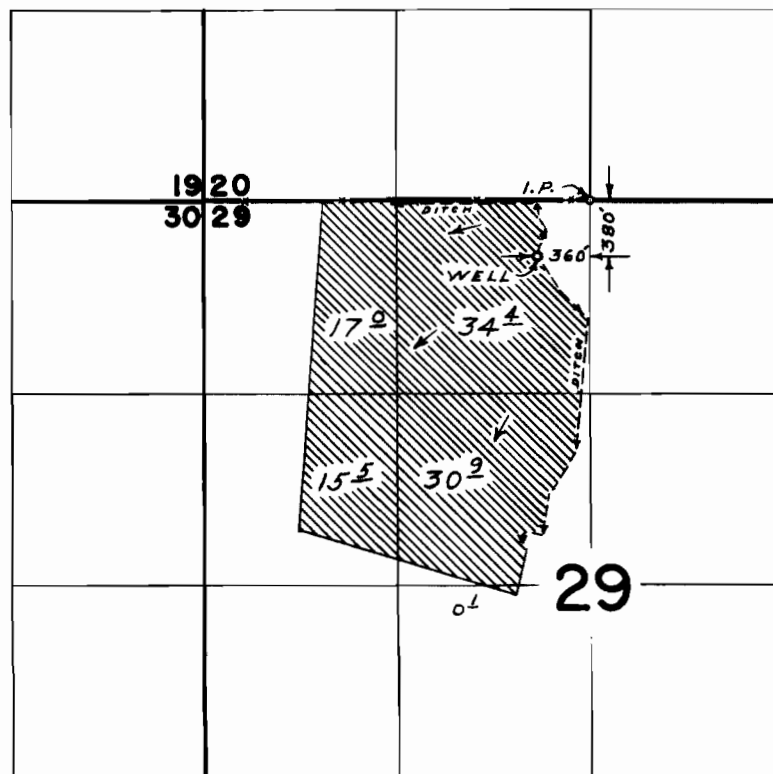

**FINAL PROOF SURVEY**  
UNDER

Application No. G-1755 Permit No. G-1604  
IN NAME OF

**CHAS. A. BECKLEY**

Surveyed **SEPT. 11, 1968**, by **W. J. RUPPERT**